

APPROVED LAND CORNER  
P.A. 345 OF 1990  
MIDLAND COUNTY

SURVEY &  
REMONUMENTATION

REMON. COR. C-11, LARKIN TWP.  
LAND CORNER RECORDATION CERTIFICATE  
Filing Requirement of Act 74, Mich. P.A. 1970

FEB 24 1998

SECTION  
328

For corners in  
Midland  
(County)

- |                                       |                           |             |
|---------------------------------------|---------------------------|-------------|
| 1. Public Land Survey                 | T <u>15</u> N R <u>2E</u> | <u>C-11</u> |
|                                       | T ___ R ___               | _____       |
|                                       | T ___ R ___               | _____       |
|                                       | T ___ R ___               | _____       |
| 2. Property Controlling<br>In Section | S ___ T ___ R ___         | _____       |
|                                       | S ___ T ___ R ___         | _____       |
| 3. Miscellaneous<br>Property in Sec.  | S ___ T ___ R ___         | _____       |
|                                       | S ___ T ___ R ___         | _____       |
| 4. Lot No. _____, Recorded Plat _____ |                           |             |
| 5. Private Claims _____               |                           |             |

STATE OF MICHIGAN  
MIDLAND COUNTY  
REMONUMENTATION & FILED

8 DEC 97 11:05 A.M.

Register of Deeds Stamp & File Number  
BEVERLY J. THAYER  
REGISTER OF DEEDS


I, RODNEY CLAYPOOL, in a field survey on Feb 12, 1996, do hereby certify that under requirements of P.A. 74, Michigan P.A. of 1970, the corner points mentioned on lines 1 and 2 above were in conformance with regulations and rules therefore as required in the current manual of survey instructions of the United States Department of the Interior, Bureau of Land Management or by a decree of a Court of Law and/or that the corner points mentioned in lines 3, 4 and 5 above were in conformance with the rules of the Michigan Board of Land Surveyors or by a Decree of a Court of Law; re-established, monumented, re-monumented, recovered, found as expressed below:

**NOTE: Not more than 2 corners, all in the same town and range, may be recorded on this certificate.**

	A	B	C	D	E	F	G	H	I	J	K	L	M
2	6	5	4	3	2	1							
3													
4	7	8	9	10	11	12							
5													
6	18	17	16	15	14	13							
7													
8	19	20	21	22	23	24							
9													
10	30	29	28	27	26	25							
11													
12	31	32	33	34	35	36							
13													

A. Description of original monument and accessories and/or subsequent restoration:

- C-11 Corner common to Sections 29, 30, 31 and 32
- 1831, Government survey by H. Park, set corner
  - 1915, survey of E line of Sec 32 by Gibbs, no call for C-11
  - 1944, witness card from H-W records, Hunter found large stone
  - 1951, survey by Hunter, found stone
  - 1953, survey by Hunter, found stone
  - 1971, survey by Hunter, mon box
  - 1982, Ayres Associates, Sec 31 breakdown notes, no call for C-11
  - 1985, Ayres Associates, rec survey L-3, P-733, mon box
  - 1988, LCRC #652 by Ledy, found 3/4" pipe in road
  - 1989, Ayres Associates Sec 29 Breakdown notes, 3/4" pipe in mon box

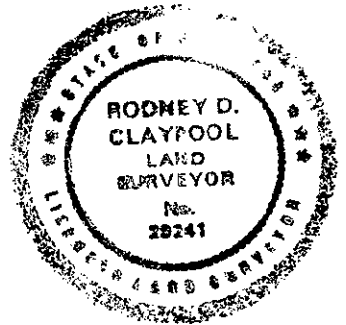

WITNESS NOTE: Witnesses from above surveys and LCRC's are available in dossier file; which was presented to peer review committee and is on file at the Register of Deeds Office.

B. Description of corner evidence found and/or method applied in restoring or reestablishing corner:

- C-11 Corner common to Sections 29, 30, 31 and 32
- Found 3/4" pipe in mon box, per survey by F. Gibbs, M. Hunter, Ayres Associates and LCRC by D. Ledy

Corner C-11 was approved for remonumentation at a Peer Review Committee Meeting on August 8, 1997.

C. Description of monument for corner and accessories established to perpetuate locating the position of the corner:

- C-11 Corner common to Sections 29, 30, 31 and 32
- Found 3/4" pipe in mon box, replaced pipe with new 3/4" pipe and brass cap stamped Midland Co. Remon Cor. PS 29241, per surveys by F. Gibbs, M. Hunter, Ayres Associates, and LCRC by D. Ledy; and is accepted to be the best available evidence of the position of the original corner.
- S 30 Deg W, 87.65', nail and plastic disc in 12" Pine
  - S 50 Deg W, 56.02', pk nail power pole
  - N 15 Deg E, 102.78', pk nail in power pole
  - S 15 Deg E, 106.55', pk nail in power pole
  - S 80 Deg E, 47.9', centerline 12" Maple
  - West 0.8', centerline N-S road

Signed by Rodney D. Claypool

Date 11-26-97

Surveyor's Michigan License No. 29241