

**SURVEY &
REMONUMENTATION**

FEB 09 2000

SECTION
LAND CORNER RECORDATION CERTIFICATE
Filing Requirement of Act 74, Mich. P.A. 1970
Midland County Remonumentation

456

1423/99 *[Signature]*

For Corners in
Midland

STATE OF MICHIGAN
MIDLAND COUNTY
RECORDED

12/1/1999 2:59:31 PM

SCOTT I. HAINES
REGISTER OF DEEDS

(County)	Located In:	Corner Code#:
1. Public Land Survey	T. <u>15N</u> R. <u>2E</u>	<u>E-4</u>
	T. _____ R. _____	_____
	T. _____ R. _____	_____
2. Public Controlling in Section	S. _____ T. _____ R. _____	_____
	S. _____ T. _____ R. _____	_____
3. Miscellaneous Property in Section	S. _____ T. _____ R. _____	_____
	S. _____ T. _____ R. _____	_____
4. Lot No. _____, Recorded Plat		
5. Private Claims		

Register of Deeds Stamp & File Number

I, Mark R. Robison, in a field survey on October 28, 1999, do hereby certify that under requirements of P.A. 74, Michigan P.A. of 1970, the corner points mentioned in lines 1 and 2 above were in conformance with regulations and rules therefore as required in the current manual of survey instructions of the United States Department of the Interior, Bureau of Land Management or by a decree of a Court of Law and/or that the corner points mentioned in lines 3, 4 and 5 above were in conformance with the rules of the Michigan Board of Land Surveyors or by a Decree of a Court of Law, established, re-established, monumented, re-monumented, recovered, found as expressed below.

	A	B	C	D	E	F	G	H	I	J	K	L	M
1													
2	6	5	4	3	2	1							
3													
4	7	8	9	10	11	12							
5													
6	18	17	16	15	14	13							
7													
8	19	20	21	22	23	24							
9													
10	30	29	28	27	26	25							
11													
12	31	32	33	34	35	36							
13													

NOTE: Not more than 2 corners, all in the same town and range, may be recorded on this certificate.

A. Description of original monument and accessories and/or subsequent restoration:

1831 Parke
40.00 1/4 Cor.
Hemlock 6 S69E 12
Hemlock 9 N73W 5

1917 Gibbs, CSR
Iron 1/4 Cor in center of Hwy
Meas. North 40.38

1983 Lapham LCRC #576
Fd 3/4" Pipe
N40E 51.35 P.P.
S40W 50.65 P.P.
S45E 37.15 N.W. Cor Store Bldg

1991 J. Jones, (132) 4-795
Fd 3/4" Pipe
N30E 51.14 Nail in guy-wire pole
S85W 45.55 C.L. P. P.
S45E 52.46 C.L. stop sign
N90E 1.00 C.L. Eastman Road

1978 Schafer, (132) 2-552
Fd 3/4" Pipe under 2" of pvm't


B. Description of corner evidence found and/or method applied in restoring or re-establishing corner:

Found 3/4" x 21" pipe over 1/2" x 18" rerod one feet East of C.L. Found one 1983 witness and two 1991 witnesses. Meas. South 2661.06 to E-5. Meas. North 2660.86 (Gibbs 2665.08) to E-3 corner is on line between E-3 and E-5.

C. Description of monument for corner and accessories established to perpetuate locating the position of the corner:

Set 3/4" x 18" Gas Pipe and rerod with Brass cap stamped Midland Co. Remon Corner P.S. #27458 in Mon. Box. Accepted as best available evidence of the original position of the corner.

Witnesses:
S56°W, 39.14 N & T in P.P.
N37°E, 51.30 N & T in P.P. (OBT)
S67°E, 108.90 N.W. Cor of new store bldg
West 45.48 N & T in P.P. (OBT)

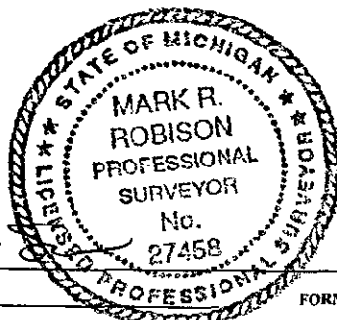

Signed by *Mark R. Robison*
Surveyor's Michigan License No. 27458

Date 12-1-99