

**SURVEY &
REMONUMENTATION**

**APPROVED LAND CORNER
P.A. 345 OF 1990
MIDLAND COUNTY**

OCT 0 8 1996

**REMON. COR. E-11, LARKIN TWP.
LAND CORNER RECORDATION CERTIFICATE COMMISSION
Filing Requirement of Act 74, Mich. P.A. 1970**

262

For corners in
Midland
(County)

Located in:	<u>T 15N R 2E</u>	Corner Code #	<u>E-11</u>
	T ___ R ___		_____
	T ___ R ___		_____
	T ___ R ___		_____
	T ___ R ___		_____
	S ___ T ___ R ___		_____
	S ___ T ___ R ___		_____
	S ___ T ___ R ___		_____
	S ___ T ___ R ___		_____

STATE OF MICHIGAN
MIDLAND COUNTY
REMONUMENTATION & FILED

22 AUG 96 8:05 A.M.

BEVERLY J THAYER
REGISTER OF DEEDS

Register of Deeds Stamp & File Number

1. Public Land Survey

2. Property Controlling
In Section

3. Miscellaneous
Property in Sec.

4. Lot No. _____, Recorded Plat _____

5. Private Claims _____

I, RODNEY CLAYPOOL, in a field survey on MAY 1, 1995, do hereby certify that under requirements of P.A. 74, Michigan P.A. of 1970, the corner points mentioned on lines 1 and 2 above were in conformance with regulations and rules therefore as required in the current manual of survey instructions of the United States Department of the Interior, Bureau of Land Management or by a decree of a Court of Law and/or that the corner points mentioned in lines 3, 4 and 5 above were in conformance with the rules of the Michigan Board of Land Surveyors or by a Decree of a Court of Law; re-established, monumented, re-monumented, recovered, found as expressed below:


NOTE: Not more than 4 corners, all in the same town and range, may be recorded on this certificate.

	A	B	C	D	E	F	G	H	I	J	K	L	M
2	6	5	4	3	2	1							
3													
4	7	8	9	10	11	12							
5													
6	18	17	16	15	14	13							
7													
8	19	20	21	22	23	24							
9													
10	30	29	28	27	26	25							
11													
12	31	32	33	34	35	36							
13													

A. Description of original monument and accessories and/or subsequent restoration:

E-11 Corner common to Sections 28, 29, 32 and 33

Survey by Government, 1830, set post
Survey by F. Gibbs, 1915, post
City Eng. Dept. 1946, Set 3/4" iron over 2" x 4" wood stake
Survey by J. Jones, 1984, 1985
Survey by D. Ledy, 1989, found iron
LCRC #558 by J. Erickson, found 5/16" rod in mon box (1982)

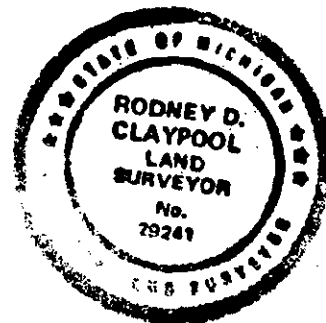

WITNESS NOTE: Witnesses from above surveys and LCRC's are available in dossier file; which was presented to peer review committee and is on file at the Register of Deeds Office.

B. Description of corner evidence found and/or method applied in restoring or reestablishing corner:

E-11 Corner common to Sections 28, 29, 32 and 33

Found 1/2" rod in mon box per surveys by F. Gibbs, J. Jones, D. Ledy, and LCRC by J. Erickson.

Corner E-11 was approved for remonumentation at a Peer Review Committee Meeting on 4/12/96.

C. Description of monument for corner and accessories established to perpetuate locating the position of the corner:

E-11 Corner common to Sections 28, 29, 32 and 33

Found 1/2" rod in mon box, replaced 1/2" rod with 5/8" rod and brass cap stamped Midland Co. Remon Cor. PS 29241 per surveys by F. Gibbs, J. Jones, D. Ledy, and LCRC by J. Erickson; and is accepted as the best available evidence of the position of the accepted corner.

S 75 Deg E, 40.37', nail and plastic disc in power pole
S 35 Deg E, 90.99', SW cor [] steel sign post
S 20 Deg W, 118.73', nail in power pole (Rec. as 119.00' in 1982)
N 40 Deg W, 69.28', nail and plastic disc in power pole
S 65 Deg W, 29.10 SW cor (broken) concrete headwall

Signed by Rodney D. Claypool Date 05-10-96

Surveyor's Michigan License No. 29241