

**SURVEY &
REMONUMENTATION**

**APPROVED LAND CORNER
P.A. 345 OF 1990
MIDLAND COUNTY**

OCT 08 1996

**REMON. COR. E-12, LARKIN TWP.
LAND CORNER RECORDATION CERTIFICATE
Filing Requirement of Act 74, Mich. P.A. 1970**

**COMMISSION
263**

4/18/96 RJC

For corners in
Midland
(County)

- | | | |
|---------------------------------------|---------------------------|-------------|
| 1. Public Land Survey | T <u>15</u> N R <u>2E</u> | <u>E-12</u> |
| | T ___ R ___ | _____ |
| | T ___ R ___ | _____ |
| | T ___ R ___ | _____ |
| 2. Property Controlling
In Section | S ___ T ___ R ___ | _____ |
| | S ___ T ___ R ___ | _____ |
| 3. Miscellaneous
Property in Sec. | S ___ T ___ R ___ | _____ |
| | S ___ T ___ R ___ | _____ |
| 4. Lot No. _____, Recorded Plat _____ | | |
| 5. Private Claims _____ | | |

STATE OF MICHIGAN
MIDLAND COUNTY
REMONUMENTATION & FILED

22 AUG 96 8:05 A.M.

BEVERLY J THAYER
REGISTER OF DEEDS

Register of Deeds Stamp & File Number


I, RODNEY CLAYPOOL, in a field survey on MAY 1, 1995, do hereby certify that under requirements of P.A. 74, Michigan P.A. of 1970, the corner points mentioned on lines 1 and 2 above were in conformance with regulations and rules therefore as required in the current manual of survey instructions of the United States Department of the Interior, Bureau of Land Management or by a decree of a Court of Law and/or that the corner points mentioned in lines 3, 4 and 5 above were in conformance with the rules of the Michigan Board of Land Surveyors or by a Decree of a Court of Law; re-established, monumented, re-monumented, recovered, found as expressed below:

	A	B	C	D	E	F	G	H	I	J	K	L	M
2	6	5	4	3	2	1							
3													
4	7	8	9	10	11	12							
5													
6	18	17	16	15	14	13							
7													
8	19	20	21	22	23	24							
9													
10	30	29	28	27	26	25							
11													
12	31	32	33	34	35	36							
13													

NOTE: Not more than 4 corners, all in the same town and range, may be recorded on this certificate.

A. Description of original monument and accessories and/or subsequent restoration:

- E-12 1/4 corner common to Sections 32 and 33
Survey by Government, 1830's, set post
Survey by F. Gibbs, 1915, post in highway
Survey by M. Hunter, 1953, set corner
Survey by M. Hunter, 1955, found corner
Survey by D. Whittier, 1966, found corner
Survey by J. Jones 1985, 1989, 1991, found rod in mon box
Survey by D. Ledy, 1988, 1989, found iron in mon box
LCRC by J. Erickson, found 1/2" rod in mon box

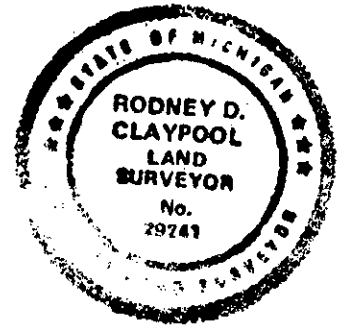

WITNESS NOTE: Witnesses from above surveys and LCRC's are available in dossier file; which was presented to peer review committee and is on file at the Register of Deeds Office.

B. Description of corner evidence found and/or method applied in restoring or reestablishing corner:

- E-12 1/4 corner common to Sections 32 and 33
Found 3/4" pipe in mon box per surveys by F. Gibbs, M. Hunter, D. Whittier, J. Jones, D. Ledy, and LCRC by J. Erickson.
NOTE: Corner was removed during Eastman Road reconstruction in 1991 and replaced using Midland Mall survey notes by R. Claypool after construction. (1991)

Corner E-12 was approved for remonumentation at a Peer Review Committee Meeting on 4/18/96.

C. Description of monument for corner and accessories established to perpetuate locating the position of the corner:

- E-12 1/4 corner common to Sections 32 and 33
Found 3/4" pipe in mon box, replaced 3/4" pipe with new 3/4" pipe and brass cap stamped Midland Co. Remon Cor. PS 29241 in mon box per surveys by F. Gibbs, M. Hunter, D. Whittier, J. Jones, D. Ledy, and LCRC by J. Erickson; and is accepted as the best available evidence of the position of the accepted corner.
N 35 Deg W, 81.50', pk nail in power pole
N 70 Deg W, 36.81', NE bolt on signal base
N 80 Deg E, 49.59', NW bolt on signal base
N 25 Deg E, 85.22', centerline tel manhole

Signed by Rodney D. Claypool

Date 05-10-96

Surveyor's Michigan License No. 29241