

**SURVEY &  
REMONUMENTATION**

**APPROVED LAND CORNER  
P.A. 345 OF 1990  
MIDLAND COUNTY**

APR 28 1995 101

**91**

**LAND CORNER RECORDATION CERTIFICATE  
Filing Requirement of Act 74, Mich. P.A. 1970**

For corners in

<u>MIDLAND</u> (County)	Located In:	Corner Code $\neq$
1. Public Land Survey	T <u>15N</u> R <u>2E</u>	<u>G-2</u>
	T _____ R _____	_____
	T _____ R _____	_____
	T _____ R _____	_____
2. Property Controlling in Section	S _____ T _____ R _____	_____
	S _____ T _____ R _____	_____
3. Miscellaneous Property in Sec.	S _____ T _____ R _____	_____
	S _____ T _____ R _____	_____

STATE OF MICHIGAN  
MIDLAND COUNTY  
FILED OREMON

28 SEP 94 3:30 P.M.

BEVERLY J THAYER  
REGISTER OF DEEDS

**Register of Deeds Stamp & File Number**

4. Lot No. \_\_\_\_\_, Recorded Plat \_\_\_\_\_  
5. Private Claims \_\_\_\_\_

	A	B	C	D	E	F	G	H	I	J	K	L	M
2	6	5	4	3	2	1							
3													
4	7	8	9	10	11	12							
5													
6	18	17	16	15	14	13							
7													
8	19	20	21	22	23	24							
9													
10	30	29	28	27	26	25							
11													
12	31	32	33	34	35	36							
13													

I, PAUL B. LAPHAM, in a field survey on MAY, 19 94, do hereby certify that under requirements of P.A. 74, Michigan P.A. of 1970, the corner points mentioned in lines 1 and 2 above were in conformance with regulations and rules therefore as required in the current manual of survey instructions of the United States Department of the Interior, Bureau of Land Management or by a decree of a Court of Law and/or that the corner points mentioned in lines 3, 4 and 5 above were in conformance with the rules of the Michigan Board of Land Surveyors or by a Decree of a Court of Law; established, re-established, monumented, re-monumented, recovered, found as expressed below:

**NOTE: Not more than 4 corners, all in the same town and range, may be recorded on this certificate.**

**A. Description of original monument and accessories and/or subsequent restoration:**

- G-2: 1/4 Corner common to Section 3 and 4  
1831 - Harvey Parke, Maple 16" S 22°E 18 Lks  
Maple 22" N 60°W 11 Lks
- 4-12-15 - Gibbs, Set old gun barrel at avg. dist. on true line CSR-P. 366-67
- 4-2-80 - Jerry Jones, found 3/4" pipe - LCRC 4-7-80  
1. East, 44.85' - Nail in P.P.  
2. S 45°W, 90.45' - Nail in 24" Pine
- 4-23-79 Ayres & Assoc. File copy of Sec. 4, unrecorded
- 5-82 Ayres & Assoc. File copy of Sec. 3, unrecorded

**B. Description of corner evidence found and/or method applied in restoring or reestablishing corner:**


- G-2: 1/4 Corner common to Section 3 and 4  
Found 3/4" x 16" pipe, excavated to depth of 3', Found no other evidence.  
meas. North 1319.23 to 1-1/2" pipe at 1/8th Corner as verified by Ayres & associates notes.  
Found witnesses 1 & 2 as noted above.

Accepted as best available evidence of the position of the original corner & replaced with Standard Monument.

Corner G-2 was approved for remonumentation at a Peer Review Committee Meeting on Sept 21, 1994.

**C. Description of monument for corner and accessories established to perpetuate locating the position of the corner:**

- G-2: 1/4 Corner common to Section 3 and 4  
Set 5/8" x 36" re-rod with brass cap stamped "Midland Co. Remon. Cor. PS 9433"
- East, 44.85' - Nail in Power Pole (No.1)
- S 45°W, 90.45' - Nail in 28" pine (No.2)
- N 80°W, 37.35' - Spike & Tag in 16" Poplar
- S 20°E, 72.5' - Spike & Tag in 10" Twin Basswood

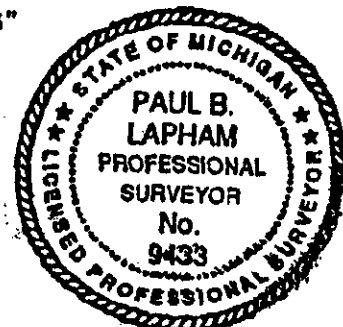

Signed by Paul B. Lapham Date 9-27-94  
Surveyor's Michigan License No. 9433