

**SURVEY &  
REMONUMENTATION**

**APPROVED LAND CORNER  
P.A. 345 OF 1990  
MIDLAND COUNTY**

APR 28 1995

103

**COMMISSION  
LAND CORNER RECORDATION CERTIFICATE  
Filing Requirement of Act 74, Mich. P.A. 1970**

For corners in

MIDLAND (County)	Located In:	Corner Code #
1. Public Land Survey	T 15N R 2E	G-3
	T R	
	T R	
	T R	
2. Property Controlling in Section	S T R	
	S T R	
3. Miscellaneous Property in Sec.	S T R	
	S T R	

STATE OF MICHIGAN  
MIDLAND COUNTY  
FILED *REMON*

28 SEP 94 3:33 P.M.

BEVERLY J THAYER  
REGISTER OF DEEDS

**Register of Deeds Stamp & File Number**

4. Lot No. \_\_\_\_\_, Recorded Plat \_\_\_\_\_  
5. Private Claims \_\_\_\_\_

	A	B	C	D	E	F	G	H	I	J	K	L	M
2	6	5	4	3	2	1							
3													
4	7	8	9	10	11	12							
5													
6	18	17	16	15	14	13							
7													
8	19	20	21	22	23	24							
9													
10	30	29	28	27	26	25							
11													
12	31	32	33	34	35	36							
13													

PAUL B. LAPHAM in a field survey on MAY 19 94, do hereby certify that under requirements of P.A. 74, Michigan P.A. of 1970, the corner points mentioned in lines 1 and 2 above were in conformance with regulations and rules therefore as required in the current manual of survey instructions of the United States Department of the Interior, Bureau of Land Management or by a decree of a Court of Law and/or that the corner points mentioned in lines 3, 4 and 5 above were in conformance with the rules of the Michigan Board of Land Surveyors or by a Decree of a Court of Law; established, re-established, monumented, re-monumented, recovered, found as expressed below:

**NOTE: Not more than 4 corners, all in the same town and range, may be recorded on this certificate.**

**A. Description of original monument and accessories and/or subsequent restoration:**

- G-3: Corner common to Section 3, 4, 9 and 10  
1831 - Harvey Parke, Hemlock 36" S 71°E 12 Lks  
Lynn 10" N 71°W 23 Lks
- 4-12-15 - Gibbs, Gas pipe old corner CSR-P. 366-67
- 3-20-74 - Jerome Schaefer, Found 3/4" pipe 10"± deep LCRC/3-28-74
  - 1. S 50°E - Nail & Disc in P.P. - 53.30'
  - 2. S 45°W - Nail & Disc in Tele. Pole - 43.55'
  - 3. N 45°E - C Road Sign - 42.26'
- 2-1-84 - Edmonds Eng. (132) 3-543
  - 4. S.W. 42.8' to Tele. Pedestal
  - 1. S.E. 53.0' to face U. Pole

**B. Description of corner evidence found and/or method applied in restoring or reestablishing corner:**


- G-3: Corner common to Section 3, 4, 9 and 10  
Found 1/4" x 18" Re-rod in 3/4" x 36" pipe. Excavated to depth of 3 feet. Did not find further evidence.  
Found recorded witnesses No. 1, 2, 3 and 4 as noted above.

Accepted as best available evidence of the position of the original corner & replaced with Standard Monument.

Corner G-3 was approved for remonumentation at a Peer Review Committee Meeting on SEPT 21, 1994.

Description of monument for corner and accessories established to perpetuate locating the position of the corner:

- G-3: 1/4 Corner common to Section 3, 4, 9 and 10  
Se: 5/8" x 36" re-rod with brass cap stamped "Midland Co. Remon. Cor. PS 9433" in Mon. Box.
- S 50°E, 53.30' - Nail and Disc in Power Pole (No.1)
- S 45°W, 43.55' - Nail and Disc in Tele. Pole (No.2)
- N 45°E, 42.26' - Road Sign (No.3)
- N 45°E, 52.52' - Nail & Disc in 10" Jack Pine

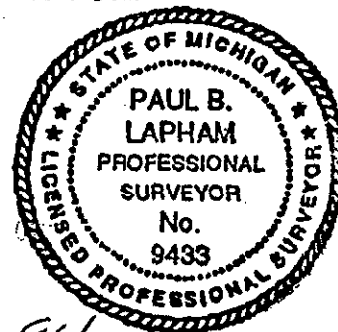

igned by Paul B. Lapham  
urveyor's Michigan License No. 9433

Date 9-22-94