

**SURVEY &
REMONUMENTATION**

APR 28 1995

COMMISSION

**APPROVED LAND CORNER
P.A. 345 OF 1990
MIDLAND COUNTY**

REMON. COR. G-9, LARKIN TOWNSHIP
LAND CORNER RECORDATION CERTIFICATE
Filing Requirement of Act 74, Mich. P.A. 1970

166

For corners in
Midland
(County)

	Located in:	Corner Code #
1. Public Land Survey	T <u>15N</u> R <u>2E</u>	<u>G-9</u>
	T ___ R ___	_____
	T ___ R ___	_____
	T ___ R ___	_____
2. Property Controlling in Section	S ___ T ___ R ___	_____
	S ___ T ___ R ___	_____
3. Miscellaneous Property in Sec.	S ___ T ___ R ___	_____
	S ___ T ___ R ___	_____
4. Lot No. _____, Recorded Plat _____		
5. Private Claims _____		

STATE OF MICHIGAN
MIDLAND COUNTY
REMONUMENTATION & FILED

12 DEC 94 9:49 A.M.

BEVERLY J THAYER
REGISTER OF DEEDS

Register of Deeds Stamp & File Number

I, RODNEY CLAYPOOL, in a field survey on February 11, 1994, do hereby certify that under requirements of P.A. 74, Michigan P.A. of 1970, the corner points mentioned on lines 1 and 2 above were in conformance with regulations and rules therefore as required in the current manual of survey instructions of the United States Department of the Interior, Bureau of Land Management or by a decree of a Court of Law and/or that the corner points mentioned in lines 3, 4 and 5 above were in conformance with the rules of the Michigan Board of Land Surveyors or by a Decree of a Court of Law; re-established, monumented, re-monumented, recovered, found as expressed below:


NOTE: Not more than 4 corners, all in the same town and range, may be recorded on this certificate.

	A	B	C	D	E	F	G	H	I	J	K	L	M
2	6	5	4	3	2	1							
3													
4	7	8	9	10	11	12							
5													
6	18	17	16	15	14	13							
7													
8	19	20	21	22	23	24							
9													
10	30	29	28	27	26	25							
11													
12	31	32	33	34	35	36							
13													

A. Description of original monument and accessories and/or subsequent restoration:

- G-9 Corner common to Sections 21, 22, 27 and 28
- Government survey 1830's, set post
- Survey by F. Gibbs, set post and stone old corner
- Survey by M. Hunter, 1955, 1958, 1961, found corner
- Survey by M. Hunter, 1965, Fitak Subdivision No. 1
- Survey by J. Schafer, 1971, found 3/4" pipe in mon box
- Survey by D. Whittier, 1972, found mon box
- Survey and LCRC by J. Schafer, 1974, 3/4" iron in mon box
- Survey by J. Jones, 1984, 1985, found 3/4" pipe in mon box
- Survey by P. Lapham, 1989, mon box
- Survey by D. Ledy, 1991, found boat spike in mon box
- Survey by J. Jones, 1991, found mon box
- LCRC by J. Erickson, 1982, found 5/8" pipe in mon box

WITNESS NOTE: Witnesses from above surveys and LCRC's are available in dossier file; which was presented to peer review committee and is on file at the Register of Deeds Office.

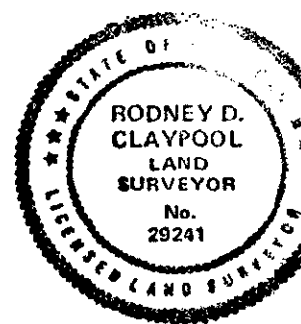

B. Description of corner evidence found and/or method applied in restoring or reestablishing corner:

- G-9 Corner common to Sections 21, 22, 27 and 28
- Found 3/4" pipe in mon box (replaced pipe with 3/4" pipe and brass cap) per surveys by F. Gibbs, M. Hunter, J. Schafer, D. Whittier, J. Jones, P. Lapham, D. Ledy, and LCRC by J. Erickson.

Corner G-9 was approved for remonumentation at a Peer Review Committee Meeting on DEC 1, 1994

C. Description of monument for corner and accessories established to perpetuate locating the position of the corner:

- G-9 Corner common to Sections 21, 22, 27 and 28
- Found 3/4" pipe in mon box (replaced pipe with 3/4" pipe and brass cap stamped Midland Co. Remon Cor. PS 29241) per surveys by F. Gibbs, M. Hunter, J. Schafer, D. Whittier, J. Jones, P. Lapham, D. Ledy and LCRC by J. Erickson and is accepted as the best available evidence of the accepted position of the corner.
- N 20 Deg E, 86.36', nail and plastic disc in 18" Ash
- N 45 Deg W, 44.06', nail and disc in telephone pole
- S 30 Deg W, 62.23', nail and MDOT disc in power pole
- S 45 Deg E, 71.04', nail in telephone pole stub
- S 48 Deg E, 75.53', nail and plastic disc in power pole

Signed by Rodney D. Claypool Date 12-09-94

Surveyor's Michigan License No. 29241