

**SURVEY &  
REMONUMENTATION**

APR 28 1995

**COMMISSION**

**APPROVED LAND CORNER  
P.A. 345 OF 1990  
MIDLAND COUNTY**

REMON. COR. G-10, LARKIN TOWNSHIP  
LAND CORNER RECORDATION CERTIFICATE  
Filing Requirement of Act 74, Mich. P.A. 1970

**167**

For corners in  
Midland  
(County)

1. Public Land Survey

Located in: T 15N R 2E Corner Code # G-10

2. Property Controlling  
in Section

	T	R	_____
	T	R	_____
	T	R	_____
S	T	R	_____
S	T	R	_____
S	T	R	_____
S	T	R	_____

3. Miscellaneous  
Property in Sec.

4. Lot No. \_\_\_\_\_, Recorded Plat

5. Private Claims \_\_\_\_\_

STATE OF MICHIGAN  
MIDLAND COUNTY  
REMONUMENTATION & FILED

12 DEC 94 9:49 A.M.

BEVERLY J THAYER  
REGISTER OF DEEDS

Register of Deeds Stamp & File Number


I, RODNEY CLAYPOOL, in a field survey on February 18, 1994, do hereby certify that under requirements of P.A. 74, Michigan P.A. of 1970, the corner points mentioned on lines 1 and 2 above were in conformance with regulations and rules therefore as required in the current manual of survey instructions of the United States Department of the Interior, Bureau of Land Management or by a decree of a Court of Law and/or that the corner points mentioned in lines 3, 4 and 5 above were in conformance with the rules of the Michigan Board of Land Surveyors or by a Decree of a Court of Law; re-established, monumented, re-monumented, recovered, found as expressed below:

	A	B	C	D	E	F	G	H	I	J	K	L
2	6	5	4	3	2	1						
3												
4	7	8	9	10	11	1						
5												
6	18	17	16	15	14	1						
7												
8	19	20	21	22	23	2						
9												
10	30	29	28	27	26	2						
11												
12	31	32	33	34	35	3						
13												

**NOTE: Not more than 4 corners, all in the same town and range, may be recorded on this certificate.**

**A. Description of original monument and accessories and/or subsequent restoration:**

- G-10 Corner common to Sections 27 and 28
- Government survey 1830's, set post
- Survey by M. Hunter, 1956, 1968, found mon box
- Survey by J. Jones, 1981, 1983, found PK nail
- Survey by M. MacDonald, 1984, Found PK nail
- Survey by and LCRC by D. Ledy, 1991, found PK nail
- Survey by J. Jones, 1992, found PK nail
- LCRC by J. Erickson, 1992, found 3/4" pipe in mon box

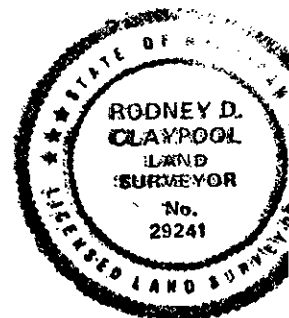

**WITNESS NOTE:** Witnesses from above surveys and LCRC's are available in dossier file; which was presented to peer review committee and is on file at the Register of Deeds Office.

**B. Description of corner evidence found and/or method applied in restoring or reestablishing corner:**

- G-10 Corner common to Sections 27 and 28
- Found PK nail (replaced with 5/8" rod and brass cap) per surveys by M. Hunter, J. Jones, M. MacDonald, D. Ledy and LCRC by J. Erickson.

Corner G-10 was approved for remonumentation at a Peer Review Committee Meeting on DEC 1, 1994

**C. Description of monument for corner and accessories established to perpetuate locating the position of the corner:**

- G-10 Corner common to Sections 27 and 28
- Found PK nail (replaced with 5/8" rod and brass cap stamped Midland Co. Remon Cor. PS 29241 in mon box) per surveys by M. Hunter, J. Jones, MacDonald, D. Ledy, and LCRC by J. Erickson and is accepted as the best available evidence of the accepted position of the corner.
- S 45 Deg E, 46.70', centerline 6" vert. steel pipe
- S 60 Deg E, 64.21', nail and MDOT tag in power pole
- N 10 Deg E, 210.78', nail and plastic disc in power pole
- N 75 Deg E, 27.75', N. rivet on East end CMP
- N 75 Deg W, 25.81', S. rivet on West end CMP
- S 45 Deg W, 47.62', nail in cor fence post

Signed by Rodney D. Claypool Date 12-09-94

Surveyor's Michigan License No. 29241