

**SURVEY &
REMONUMENTATION**

APR 28 1995

**APPROVED LAND CORNER
P.A. 345 OF 1990
MIDLAND COUNTY**

COMMISSION

REMON. COR. G-12, LARKIN TOWNSHIP
LAND CORNER RECORDATION CERTIFICATE
Filing Requirement of Act 74, Mich. P.A. 1970

168

12/01/94 gsc

For corners in
Midland

| | | |
|---------------------------------------|--------------------------|---------------|
| (County) | Located in: | Corner Code # |
| 1. Public Land Survey | T <u>15N</u> R <u>2E</u> | <u>G-12</u> |
| | T ___ R ___ | _____ |
| | T ___ R ___ | _____ |
| | T ___ R ___ | _____ |
| 2. Property Controlling in Section | S ___ T ___ R ___ | _____ |
| | S ___ T ___ R ___ | _____ |
| 3. Miscellaneous Property in Sec. | S ___ T ___ R ___ | _____ |
| | S ___ T ___ R ___ | _____ |
| 4. Lot No. _____, Recorded Plat _____ | | |
| 5. Private Claims _____ | | |

STATE OF MICHIGAN
MIDLAND COUNTY
REMONUMENTATION & FILED

12 DEC 94 9:50 A.M.

BEVERLY J THAYER
REGISTER OF DEEDS

Register of Deeds Stamp & File Number


I, RODNEY CLAYPOOL, in a field survey on February 18, 1994, do hereby certify that under requirements of P.A. 74, Michigan P.A. of 1970, the corner points mentioned on lines 1 and 2 above were in conformance with regulations and rules therefore as required in the current manual of survey instructions of the United States Department of the Interior, Bureau of Land Management or by a decree of a Court of Law and/or that the corner points mentioned in lines 3, 4 and 5 above were in conformance with the rules of the Michigan Board of Land Surveyors or by a Decree of a Court of Law; re-established, monumented, re-monumented, recovered, found as expressed below:

NOTE: Not more than 4 corners, all in the same town and range, may be recorded on this certificate.

| | | | | | | | | | | | | |
|----|----|----|----|----|----|---|---|---|---|---|---|---|
| | A | B | C | D | E | F | G | H | I | J | K | L |
| 2 | 6 | 5 | 4 | 3 | 2 | | | | | | | |
| 3 | | | | | | | | | | | | |
| 4 | 7 | 8 | 9 | 10 | 11 | | | | | | | |
| 5 | | | | | | | | | | | | |
| 6 | 18 | 17 | 16 | 15 | 14 | | | | | | | |
| 7 | | | | | | | | | | | | |
| 8 | 19 | 20 | 21 | 22 | 23 | | | | | | | |
| 9 | | | | | | | | | | | | |
| 10 | 30 | 29 | 28 | 27 | 26 | | | | | | | |
| 11 | | | | | | | | | | | | |
| 12 | 31 | 32 | 33 | 34 | 35 | | | | | | | |
| 13 | | | | | | | | | | | | |

A. Description of original monument and accessories and/or subsequent restoration:

- G-12 Corner common to Sections 33 and 34
- Government survey 1830, set wood post
 - Survey by F. Gibbs, 1919, stone for 1/4 corner
 - Survey by M. Hunter, 1957 found stone
 - Survey by D. Whittier, 1969, 1972, found corner
 - Survey by J. Schafer, 1972, 1975, found corner
 - Survey by J. Jones, 1989, found PK nail
 - Survey by P. Lapham, 1989, 1990, Assessor's Plat of Julie Ann Estates
 - Survey by P. Lapham, 1992, found 3/4" pipe in mon box
 - Survey by D. Ledy, 1992, found 3/4" pipe in mon box
 - Survey by M. Robison, 1993, found 3/4" pipe in mon box
 - LCRC by J. Erickson, 1982, found 3/4" pipe in mon box

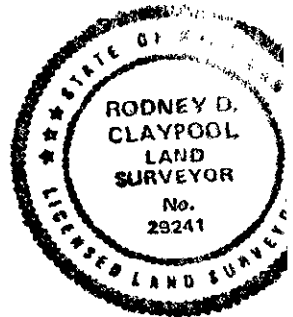

WITNESS NOTE: Witnesses from above surveys and LCRC's are available in dossier file; which was presented to peer review committee and is on file at the Register of Deeds Office.

B. Description of corner evidence found and/or method applied in restoring or reestablishing corner:

- G-12 Corner common to Sections 33 and 34
- Found PK nail (replaced with 5/8" rod and brass cap) per surveys by F. Gibbs, M. Hunter, D. Whittier, J. Schafer, J. Jones, P. Lapham, D. Ledy, M. Robison and LCRC by J. Erickson.

Corner G-12 was approved for remonumentation at a Peer Review Committee Meeting on DEC 1, 1994

C. Description of monument for corner and accessories established to perpetuate locating the position of the corner:

- G-12 Corner common to Sections 33 and 34
- Found PK nail (replaced with 5/8" rod and brass cap stamped Midland Co. Remon Cor. PS 29241 in mon box) per surveys by F. Gibbs, M. Hunter, Whittier, J. Schafer, J. Jones, P. Lapham, D. Ledy, M. Robison and LCRC by J. Erickson and is accepted as the best available evidence of the acco position of the corner.
- S 87 Deg E, 46.36', MDOT nail and disc in fence post
 - S 35 Deg E, 66.22', nail and plastic disc in power pole
 - S 25 Deg W, 100.70', nail and plastic disc in 15" Pine
 - N 86 Deg W, 40.97', nail and plastic disc in 10" Pine

Signed by Rodney D. Claypool Date 12-09-94