

SURVEY &
REMONUMENTATION

NOV 07 1994

COMMISSION

APPROVED LAND CORNER
P.A. 345 OF 1990
MIDLAND COUNTY

219 4/6/94

83

REMON. COR. K-2, LARKIN TOWNSHIP
LAND CORNER RECORDATION CERTIFICATE
Filing Requirement of Act 74, Mich. P.A. 1970

STATE OF MICHIGAN
MIDLAND COUNTY
REMONUMENTATION & FILED

18 APR 94 2:19 P.M.

BEVERLY J THAYER
REGISTER OF DEEDS

For corners in
Midland

(County)

Located in: Corner Code #

- | | | |
|---------------------------------------|------------|-----|
| 1. Public Land Survey | T 15N R 2E | K-2 |
| | T R | |
| | T R | |
| | T R | |
| 2. Property Controlling
in Section | S T R | |
| | S T R | |
| 3. Miscellaneous
Property in Sec. | S T R | |
| | S T R | |
4. Lot No. _____, Recorded Plat _____
5. Private Claims _____

Register of Deeds Stamp & File Number

A B C D E F G H I J K L M


2	6	5	4	3	2	1
3						
4	7	8	9	10	11	12
5						
6	18	17	16	15	14	13
7						
8	19	20	21	22	23	24
9						
10	30	29	28	27	26	25
11						
12	31	32	33	34	35	36
13						

I, RODNEY CLAYPOOL, in a field survey on DECEMBER, 1993, do hereby certify that under requirements of P.A. 74, Michigan P.A. of 1970, the corner points mentioned on lines 1 and 2 above were in conformance with regulations and rules therefore as required in the current manual of survey instructions of the United States Department of the Interior, Bureau of Land Management or by a decree of a Court of Law and/or that the corner points mentioned in lines 3, 4 and 5 above were in conformance with the rules of the Michigan Board of Land Surveyors or by a Decree of a Court of Law; re-established, monumented, re-monumented, recovered, found as expressed below:

NOTE: Not more than 4 corners, all in the same town and range, may be recorded on this certificate.

A. Description of original monument and accessories and/or subsequent restoration:

- K-2 Corner common to Sections 1 and 2
Wood post Government survey 1830
Pine 24", S 63 Deg E, 7 L (4.62')
Thorn 7", S 81 Deg W, 14 L (9.24')
Survey by J. Jones 1982
Set 1/2" rod (by prorating mile distance with Government distances)
- Survey by J. Jones 1993
Found 1/2" rod at Glo prorated distance
N 80 Deg W, centerline of 8" Maple, 36.0'
11' West of centerline blacktop N-S
44.2' North of centerline fence to West
- Survey by D. Ledy 1989
Set rod at end of occupation on line
Northwest 65.14', nail in 5" Maple
North 55 Deg E, 127.50', nail in 24" Oak
East 46.39', nail in fence post
West 28.24', nail in fence post
NOTE: This corner was set improperly and should not be used.

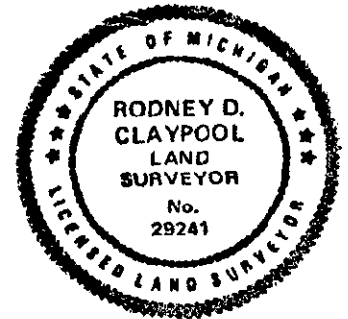

B. Description of corner evidence found and/or method applied in restoring or reestablishing corner:

- K-2 1/4 Corner Common to Sections 1 and 2
Found 1/2" rod 11' West of centerline blacktop road (replaced 1/2" rod with 3/4" pipe and brass cap) per survey by J. Jones.

Corner K-2 was approved for remonumentation at a Peer Review Committee Meeting on April 6, 1994.

C. Description of monument for corner and accessories established to perpetuate locating the position of the corner:

- K-2 1/4 Corner common to Sections 1 and 2
- Found 1/2" rod (replaced with 3/4" pipe and brass cap stamped "Midland Co. Remon. Cor. PS 29241" set in monument box) per surveys by J. Jones and is accepted as the best available evidence of the reestablishment of the perpetuated corner
N 85 Deg W, 35.9', centerline 10" Maple South 43.97', 1/2" rod
N 30 Deg W, 153.71', nail in plastic disc in power pole East 11.0', centerline blacktop road
S 70 Deg E, 101.51', nail in plastic disc in 24" Oak

Signed by Rodney D. Claypool Date 04-15-94