

SURVEY &  
REMONUMENTATION

NOV 07 1994

COMMISSION

REMON. COR. M-2, LARKIN TOWNSHIP  
LAND CORNER RECORDATION CERTIFICATE  
Filing Requirement of Act 74, Mich. P.A. 1970

APPROVED LAND CORNER  
P.A. 345 OF 1990  
MIDLAND COUNTY

909 2/24/94

76

For corners in  
Midland  
(County)

- |                                       |                          |            |
|---------------------------------------|--------------------------|------------|
| 1. Public Land Survey                 | T <u>15N</u> R <u>2E</u> | <u>M-2</u> |
|                                       | T ___ R ___              | _____      |
|                                       | T ___ R ___              | _____      |
|                                       | T ___ R ___              | _____      |
| 2. Property Controlling<br>in Section | S ___ T ___ R ___        | _____      |
|                                       | S ___ T ___ R ___        | _____      |
| 3. Miscellaneous<br>Property in Sec.  | S ___ T ___ R ___        | _____      |
|                                       | S ___ T ___ R ___        | _____      |
| 4. Lot No. _____, Recorded Plat _____ |                          |            |
| 5. Private Claims _____               |                          |            |

STATE OF MICHIGAN  
MIDLAND COUNTY  
REMONUMENTATION & FILED

15 MAR 94 9:03 A.M.

BEVERLY J THAYER  
REGISTER OF DEEDS

Register of Deeds Stamp & File Number

	A	B	C	D	E	F	G	H	I	J	K	L	M
2	6	5	4	3	2	1							
3													
4	7	8	9	10	11	12							
5													
6	18	17	16	15	14	13							
7													
8	19	20	21	22	23	24							
9													
10	30	29	28	27	26	25							
11													
12	31	32	33	34	35	36							
13													

I, RODNEY CLAYPOOL, in a field survey on DECEMBER, 1993, do hereby certify that under requirements of P.A. 74, Michigan P.A. of 1970, the corner points mentioned on lines 1 and 2 above were in conformance with regulations and rules therefore as required in the current manual of survey instructions of the United States Department of the Interior, Bureau of Land Management or by a decree of a Court of Law and/or that the corner points mentioned in lines 3, 4 and 5 above were in conformance with the rules of the Michigan Board of Land Surveyors or by a Decree of a Court of Law; re-established, monumented, re-monumented, recovered, found as expressed below:

**NOTE: Not more than 4 corners, all in the same town and range, may be recorded on this certificate.**

A. Description of original monument and accessories and/or subsequent restoration:

M-2  
East 1/4 Corner of Section 1

Wood post Government survey 1830's

Elm 14" 55 Deg W, 9 L (5.94')

Pine 30" N 7 Deg W, 10 L (6.6')

Survey by J. Jones 1982

Set 3/4" pipe at location established from previous survey records

W 28.75' tag in corner post

S 65 Deg W, 53.15' tag in 24" Oak

Survey by D. Ledy 1992


Found 3/4" iron

N 85 Deg W, 28.80' nail and disc in corner post

N 85 Deg E, 32.40' center top MBT box

S 45 Deg E, 59.38' nail and flag in 8" Birch

West 33.0' 1/2" iron

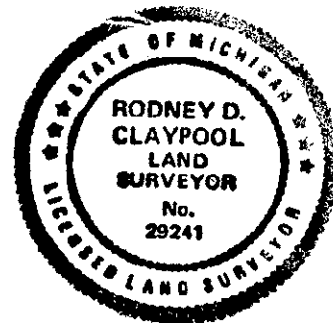

B. Description of corner evidence found and/or method applied in restoring or reestablishing corner:

M-2 Found 3/8" rod (replaced 3/8" rod with 3/4" pipe and brass cap.) per surveys by J. Jones and D. Ledy

Corner M-2 was approved for remonumentation at a Peer Review Committee Meeting on FEB 24, 1994

C. Description of monument for corner and accessories established to perpetuate locating the position of the corner:

M-2 Found 3/8" rod (replaced rod with 3/4" pipe and brass cap stamped "Midland Co. Remon. Cor. PS 29241" in monument box) per surveys by J. Jones and D. Ledy and is accepted as the best available evidence of the position of the original corner.

N 80 Deg W, 37.85' nail and plastic disc in 12" Maple

S 60 Deg W, 52.78' nail and plastic disc in 36" Oak

S 15 Deg W, 191.73' nail and plastic disc in power pole

S 15 Deg E, 186.09' nail and plastic disc in power pole

Signed by Rodney D. Claypool

Date 03-07-94

Surveyor's Michigan License No. 29241

Form approved by Michigan State Board of Land Surveyors, Jan. 28, 1971

Revised May 14, 1971

Revised Jan., 1983