

APPROVED LAND SURVEY

P.A. 345 OF 1970
MIDLAND COUNTY

LAND CORNER RECORDATION CERTIFICATE
Filing Requirement of Act 74, Mich. P.A. 1970
Midland County Remonumentation

11/23/99 *MR*

For Corners in
Midland

(County)

Located In:

Corner Code#:

- 1. Public Land Survey T. 15N R. 2E M-9
T. _____ R. _____
T. _____ R. _____
- 2. Public Controlling S. _____ T. _____ R. _____
in Section S. _____ T. _____ R. _____
- 3. Miscellaneous S. _____ T. _____ R. _____
Property in Section S. _____ T. _____ R. _____
- 4. Lot No. _____, Recorded Plat _____
- 5. Private Claims _____

STATE OF MICHIGAN
MIDLAND COUNTY
RECORDED

12/7/1999 2:59:31 PM

SCOTT I. HAINES
REGISTER OF DEEDS

Register of Deeds Stamp & File Number

I, Mark R. Robison, in a field survey on October 28, 1999, do hereby certify that under requirements of P.A. 74, Michigan P.A. of 1970, the corner points mentioned in lines 1 and 2 above were in conformance with regulations and rules therefore as required in the current manual of survey instructions of the United States Department of the Interior, Bureau of Land Management or by a decree of a Court of Law and/or that the corner points mentioned in lines 3, 4 and 5 above were in conformance with the rules of the Michigan Board of Land Surveyors or by a Decree of a Court of Law established, re-established, monumented, re-monumented, recovered, found as expressed below.

NOTE: Not more than 2 corners, all in the same town and range, may be recorded on this certificate.

	A	B	C	D	E	F	G	H	I	J	K	L	M
1													
2	6	5	4	3	2	1							
3													
4	7	8	9	10	11	12							
5													
6	18	17	16	15	14	13							
7													
8	19	20	21	22	23	24							
9													
10	30	29	28	27	26	25							
11													
12	31	32	33	34	35	36							
13													

A. Description of original monument and accessories and/or subsequent restoration:

- 1831 Parke
- 80.00 Cor Sec 24 & 25
- Elm 12 S34W 6 1/2
- B. Ash 14 N15W 21

- 1996 Ledy
- Fd 2 1/2" Pipe
- South 16.51 3/8" rod in Mon. Box
- SE 105.30 Fd nail in E/S P.P.
- NE 102.91 S.W. Cor House
- NW 22.20 C.L. Stop Sign
- Meas. South 2643.11

B. Description of corner evidence found and/or method applied in restoring or re-establishing corner:

Found 2" x 24" pipe 16.50 feet North of A-9, T15N, R3W. (GLO states A-9 falls 251ks. South of Std. Cor) A-9 is witnessed by Schafer in LCRC 02-215 Bay Co. Records. Meas. South 2643.11 to M-10. Found all 1996 witnesses.

C. Description of monument for corner and accessories established to perpetuate locating the position of the corner:

Set 3/4" x 18" reroed with Brass Cap stamped Midland Co. Remon Corner P.S. #27458 in Mon. Box. Accepted as best available evidence of the original position of the corner.

- Witnesses:
- N54°E, 102.92 S.W. Cor of house (OBT)
 - S20°E, 105.54 N & T in P.P. (OBT)
 - S59°W, 66.50 Street Road Sign
 - N44°W, 153.56 N & T in P.P.


SURVEY &
REMONUMENTATION

FEB 25 2000

SECTION

Signed by Mark R. Robison
Surveyor's Michigan License No. 27458

Date 11-29-99

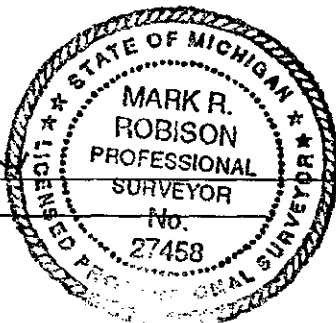

FORM APPROVED BY MICHIGAN STATE BOARD OF LAND SURVEYORS, JAN. 25, 1971