

**SURVEY &
REMONUMENTATION**

**APPROVED LAND CORNER
P.A. 345 OF 1990
MIDLAND COUNTY**

OCT 03 1996

**REMON. COR. M-11, LARKIN TWP.
LAND CORNER RECORDATION CERTIFICATE
Filing Requirement of Act 74, Mich. P.A. 1970**

**COMMISSION
265**

For corners in
Midland

STATE OF MICHIGAN
MIDLAND COUNTY
REMONUMENTATION & FILED

22 AUG 96 8:06 A.M.

BEVERLY J THAYER
REGISTER OF DEEDS

Register of Deeds Stamp & File Number

(County)	Located in:	Corner Code #
1. Public Land Survey	T 15N R 2E	M-11
	T ___ R ___	_____
	T ___ R ___	_____
	T ___ R ___	_____
2. Property Controlling in Section	S ___ T ___ R ___	_____
	S ___ T ___ R ___	_____
3. Miscellaneous Property in Sec.	S ___ T ___ R ___	_____
	S ___ T ___ R ___	_____
4. Lot No. _____, Recorded Plat _____		
5. Private Claims _____		

I, RODNEY CLAYPOOL, in a field survey on MARCH 29, 1995, do hereby certify that under requirements of P.A. 74, Michigan P.A. of 1970, the corner points mentioned on lines 1 and 2 above were in conformance with regulations and rules therefore as required in the current manual of survey instructions of the United States Department of the Interior, Bureau of Land Management or by a decree of a Court of Law and/or that the corner points mentioned in lines 3, 4 and 5 above were in conformance with the rules of the Michigan Board of Land Surveyors or by a Decree of a Court of Law; re-established, monumented, re-monumented, recovered, found as expressed below:


NOTE: Not more than 4 corners, all in the same town and range, may be recorded on this certificate.

	A	B	C	D	E	F	G	H	I	J	K	L	M
2	6	5	4	3	2	1							
3													
4	7	8	9	10	11	12							
5													
6	18	17	16	15	14	13							
7													
8	19	20	21	22	23	24							
9													
10	30	29	28	27	26	25							
11													
12	31	32	33	34	35	36							
13													

A. Description of original monument and accessories and/or subsequent restoration:

M-11 Corner common to Sections 25 and 36 on east townline

Survey by Government, 1830's, set post
Survey by F. Gibbs, 1924
Survey by M. Hunter, 1960

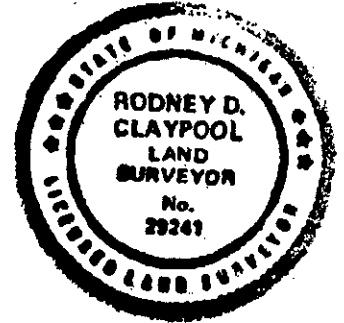

WITNESS NOTE: Witnesses from above surveys and LCRC's are available in dossier file; which was presented to peer review committee and is on file at the Register of Deeds Office.

B. Description of corner evidence found and/or method applied in restoring or reestablishing corner:

M-11 Corner common to Sections 25 and 36 on east townline

Found 1/2' rod, replaced pipe with 5/8" rod and brass cap, per surveys by F. Gibbs and M. Hunter.

Corner M-11 was approved for remonumentation at a Peer Review Committee Meeting on 4/18/96.

C. Description of monument for corner and accessories established to perpetuate locating the position of the corner:

M-11 Corner common to Sections 25 and 36 on east townline

Found 1/2' rod, replaced with 5/8" rod and brass cap stamped Midland Co. Remon Cor. PS 29241, per surveys by F. Gibbs and M. Hunter; and is accepted as the best available evidence of the position of the accepted corner.

N 40 Deg E, 58.80', pk nail and Bay Co. disc in power pole
N 45 Deg W, 44.49', "x" in top project marker
N 65 Deg W, 134.75', nail and w.t. disc in power pole
S 15 Deg W, 102.51', nail and w.t. disc in 10" Maple
South 49.58', Bay County Remon corner L003, P-91

Signed by Rodney D. Claypool Date 05-10-96

Surveyor's Michigan License No. 29241