

JAN 21 1999

APPROVED LAND CORNER
P.A. 345 OF 1980
MIDLAND COUNTY

MIDLAND County Remonumentation SECTION

LAND CORNER RECORDATION CERTIFICATE
Filing Requirement of Act 74, Mich. P.A. 1970

374

For corners in


MIDLAND (County)	Located in:	Corner Code #
1. Public Land Survey	T16N R01E	F-5
	T R	
	T R	
	T R	
2. Property Controlling in Section	S T R	
	S T R	
3. Miscellaneous Property in Sec.	S T R	
	S T R	

STATE OF MICHIGAN
MIDLAND COUNTY
REMONUMENTATION & FILED
12/16/1998 12:11:56 PM
BEVERLY J. THAYER
REGISTER OF DEEDS

Register of Deeds Stamp & File Number

4. Lot No. _____, Recorded Plat _____
5. Private Claims _____

I, Mark R Robison, in a field survey on September, 1998 do hereby state that under requirements of P.A. 74, Michigan P.A. of 1970, the corner points mention in lines 1 and 2 above were in conformance with regulations and rules therefore as required in the current manual of survey instructions of the United States Department of the Interior, Bureau of Land Management or by a decree of a Court of Law and/or that the corner points mentioned in lines 3, 4 and 5 above were in conformance with the rules of the Michigan Board of Land Surveyors or by a Decree of a Court of Law; established, re-established, monumented, recovered, found as expressed below:

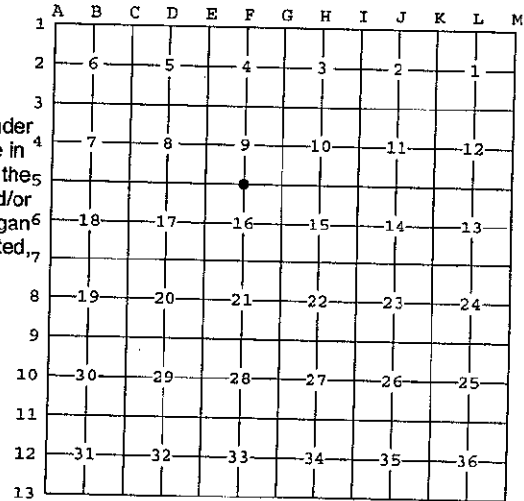

NOTE: Not more than 2 corners, all in the same town and range, may be recorded on this certificate

A. Description of original monument and accessories and/or subsequent restoration:

- F-5: 1830 Parke
Set 1/4 Sec Post
Wit-1)B. Oak 32" N12E 36 lks
2)Lynn 20" S7E 28 lks
- 5-15-72 Whittier LCRC#148
Fd halfmoon steel shaft 3' deep. Set 1/2" pipe on top. In line with Fence to North & 10.8' E of centerline CPC tower line.
Wit-1)North 98.57 Spike in P.P.

B. Description of corner evidence found and/or method applied in restoring or reestablishing corner:

F-5: Found 1/2" x 23" pipe 1 ft. South of centerline road. At 3 feet depth, found 3/4" x 30" angle iron (possible half moon steel shaft). Measured East 2626.26 to Section Corner. Measured West 2320.54 (GLO 2320.56) to Section Corner on Meridian. Found 1972 witnesses.
Corner, F-5, was approved for remonumentation at a Peer Review Committee Meeting on 9/09/98

C. Description of monument for corner and accessories established to perpetuate locating the position of the corner:

- F-5: Set 3/4" x 18" Gas Pipe with Brass Cap stamped "Midland Co. Remon. Cor. P.S.27458" in Monument Box. Accepted as best available evidence of the accepted position of the corner.



Signed by Mark R. Robison
Surveyor's Michigan License No. 27458

Date 12-09-98