

APPROVED LAND CORNER  
P.A. 345 OF 1990  
MIDLAND COUNTY

287

LAND CORNER RECORDATION CERTIFICATE  
Filing Requirement of Act 74, Mich. P.A. 1970

STATE OF MICHIGAN  
MIDLAND COUNTY  
REMONUMENTATION & FILED

27 NOV 96 2:54 P.M.

BEVERLY J THAYER  
REGISTER OF DEEDS

For corners in

MIDLAND (County)	Located In:	Corner Code #
1. Public Land Survey	T 16N R 1E	G-5
	T R	
	T R	
	T R	
2. Property Controlling in Section	S T R	
	S T R	
3. Miscellaneous Property in Sec.	S T R	
	S T R	

Register of Deeds Stamp & File Number

4. Lot No. \_\_\_\_\_, Recorded Plat \_\_\_\_\_  
5. Private Claims \_\_\_\_\_

I, PAUL B. LAPHAM, in a field survey on OCTOBER, 19 95 do hereby state that under requirements of P.A. 74, Michigan P.A. of 1970, the corner points mentioned in lines 1 and 2 above were in conformance with regulations and rules therefore as required in the current manual of survey instructions of the United States Department of the Interior, Bureau of Land Management or by a decree of a Court of Law and/or that the corner points mentioned in lines 3, 4 and 5 above were in conformance with the rules of the Michigan Board of Land Surveyors or by a Decree of a Court of Law; established, re-established, monumented, recovered, found as expressed below:

NOTE: Not more than 2 corners, all in the same town and range, may be recorded on this certificate.

	A	B	C	D	E	F	G	H	I	J	K	L	M
1													
2	6	5	4	3	2	1							
3													
4	7	8	9	10	11	12							
5													
6	18	17	16	15	14	13							
7													
8	19	20	21	22	23	24							
9													
10	30	29	28	27	26	25							
11													
12	31	32	33	34	35	36							
13													

A. Description of original monument and accessories and/or subsequent restoration:

1832 PARKE SET POST WIT.-SUGAR 8" N5°W 3 1/2 LKS. B. ASH 28" S11°E 27 LKS.	4-30-24 UNKNOWN SET 3/4" BOLT IN BUGGY HUB WIT.-S.E. - 41' ELM N.E. - 31.2' POLE N.W. - 35' POST	5-15-72 WHITTIER FOUND 3/4" BOLT (BENT) IN BUGGY HUB REMOVED. SET 3/4"x2' IRON WIT.-S40°E, 52.25' - TAG IN TELE. POLE N45°E, 36.48' - TAG IN TWIN 12" ASPEN N25°E, 53.48' - END RIVET IN E. END 12" C.M. PIPE N40°W, 67.08' - TAG IN POWER POLE FOUND 3/8" ROD 1.5' NORTH OF CORNER PULLED.
5-03-04 GIBBS, C.S.R. POST WITH IRON AT SIDE OLD CORNER NO DATE GIBBS, C.S.R. POST WITH IRON AT SIDE OLD CORNER	4-21-72 WHITTIER, (132) 1-102 FOUND CORNER	12-13-83 JONES, (132) 3-505 FOUND 3/8" ROD

B. Description of corner evidence found and/or method applied in restoring or reestablishing corner:


FOUND 3/4"x24" PIPE WITH 3/8" RE-ROD INSIDE IN CENTER OF ROAD INTERSECTION FOUND ONE O.B.T. MEAS. EAST 2648.44' (GIBBS 2644.95') TO H-5.

Corner, G-5 was approved for remonumentation at a Peer Review Committee Meeting on SEP 10, 1996.

C. Description of monument for corner and accessories established to perpetuate locating the position of the corner:

SET 3/4"x18" GAS PIPE WITH BRASS CAP STAMPED "MIDLAND CO. REMON. COR. P.S. 9433".  
ACCEPTED AS BEST AVAILABLE EVIDENCE OF THE ACCEPTED POSITION OF THE CORNER.

WITNESSES:  
S29°W, 86.06' - NAIL & TAG IN 12" SCOTCH PINE.  
S62°W, 91.97' - NAIL & TAG IN 13" SCOTCH PINE.  
S83°E, 236.00' - NAIL & TAG IN POWER POLE STUB.  
N40°W, 67.08' - NAIL & TAG IN POWER POLE (O.B.T.)

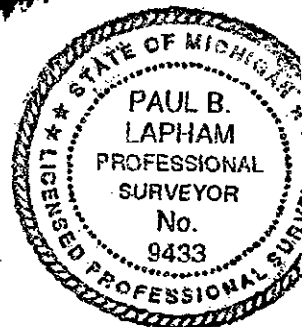

Signed by Paul B. Lapham  
Surveyor's Michigan License No. 9433

Date 10-4-96