


**LAND CORNER RECORDATION CERTIFICATE**  
 Filing Requirement of Act 74, Mich. PA 1970

For Corners In:  
Midland  
 (County)

	Located In	Corner Code #
1. Public Land Survey	T <u>16N</u> R <u>1E</u>	<u>M8</u>
	T _____ R _____	_____
2. Property Controlling in Section	S _____ T _____ R _____	_____
	S _____ T _____ R _____	_____
3. Miscellaneous Property in Section	S _____ T _____ R _____	_____
	S _____ T _____ R _____	_____

4. Lot No: \_\_\_\_\_ Recorded Plat: \_\_\_\_\_

5. Private Claims: \_\_\_\_\_

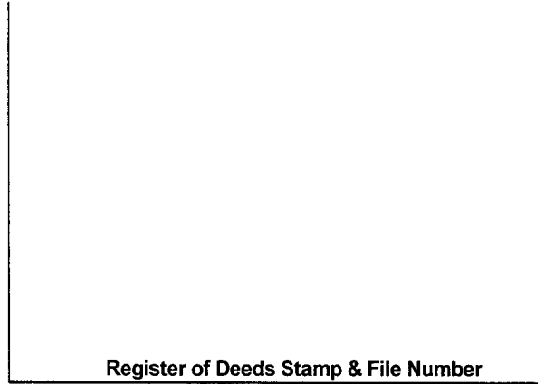

I, Craig W. McVean, in a field survey on December 2, 2009 do hereby state that under requirements of PA 74, Michigan PA of 1970, the corner points mentioned in lines 1 and 2 above were in conformance with regulations and rules therefore as required in the current manual of survey instructions of the United States Department of the Interior, Bureau of Land Management or by a decree of a Court of Law and/or that the corner points mentioned in lines 3, 4 and 5 above were in conformance with the rules of the Michigan Board of Land Surveyors or by a Decree of a Court of Law; established, re-established, monumented, recovered, found as expressed below:

**NOTE: Not more than 2 corners, all in the same town and range, may be recorded on this certificate.**

	A	B	C	D	E	F	G	H	I	J	K	L	M
1													
2	6			5		4		3		2		1	
3													
4	7			8		9		10		11		12	
5													
6	18			17		16		15		14		13	
7													
8	19			20		21		22		23		24	
9													
10	30			29		28		27		26		25	
11													
12	31			32		33		34		35		36	
13													

A. Description of original monument and accessories and/or subsequent restoration:

M8 – 1831 – GLO – Harvey Parke – Set ½ mile Post, 1) Elm 9" S34°W 14 L.; 2) Pine 9" N11°W 23 L. - 1903 – CSR – Book 1, p. 152-153 – Franklin J. Gibbs. Set W. Oak Post. 3) Elm 12" S35°W 19 L. - 1973 – Ayers & Assoc. Survey Notes Sec. 24 – J.M. Murphy, PS #9657 - Fd. Dark spot containing rotted wood in ground may have been old post set by F.T. Gibbs, but also may have been old fence post. Corner is in swampy ground about 45' N. of intermittent creek. Set 1½" Iron Pipe 3' long on calculated brg. and distance from SE. corner. Point set is about 0.3' SW of post hole, and on line with broken down fences to W and S. 4) S45°W nail and disc in 15" Elm 18.02'; 5) Due E nail and disc in twin 8" Oak 8.77'; 6) Due N nail and disc in maple clump 26.80'; 7) 1' NE of new corner fence post. - 1975 – Certificate of Survey Recorded in L. 1, P. 906 – L. D. McGinnis, PS#18999 – show corner; distance to 'A8' – 27.18'. No monument description or witnesses.

B. Description of corner evidence found and/or method applied in restoring or re-establishing corner:

M8 – Standard ¼ corner common to Section 24, T16N, R1E - Found 1 ½" I.D. (2" O.D.) iron pipe at fence intersection to South and West. Trace of fence to north. Witnesses as follows: #1, 2, 3 & 5 are gone; #4 – Stp.; #7 – OK; #6 – OK and is in position for 'A8', T16N, R2E. Also dug from the Elm stump of Wit. #4 at record bearing and distance per Gibb's witnesses #3 searching for evidence of Oak post but nothing was found. Thus it doesn't appear that witness #3 and 4 are the same tree. Found 1½" iron pipe accepted as the best available evidence of the position of the original corner.

C. Description of monument for corner and accessories established to perpetuate locating the position of the corner:

M8 – 1½" iron pipe

N39°E 54.69' to set nail & tag in NW side 10" Red Maple scribed "XBT"  
 S20°W 1.47' to fd. nail & tag #43066 in E. side corner fence post (#7)  
 S82°W 37.01' to set nail & tag in S side 12" Red Maple  
 N36°W 22.28' to set nail & tag at fd. Nail in NE side 6" Ash  
 N0°21'26"E 26.98' to 'A8', T16N, R2E being calculated position in 36" Red Maple Clump corner tree.  
 N1°08'14"W 27.01' to fd. 3/8" CIR #18999 being N88°33'W 0.71' from calculated 'A8' T16N, R2E position in corner tree

Signed by: Craig W. McVean  
 Surveyor's Michigan License No.: 39088

Date: 1/13/2010

