

APPROVED LAND CORNER
 P.A. 345 OF 1990
 MIDLAND COUNTY

LAND CORNER RECORDATION CERTIFICATE
Filing Requirement of Act 74, Mich. P.A. 1970
Midland County Remonumentation

433

11/12/99 JSG

For Corners in
Midland
 (County)

1. Public Land Survey	T. <u>16</u> R. <u>1W</u>	Corner Code#: <u>L-11</u>
	T. _____ R. _____	_____
	T. _____ R. _____	_____
2. Public Controlling in Section	S. _____ T. _____ R. _____	_____
	S. _____ T. _____ R. _____	_____
3. Miscellaneous Property in Section	S. _____ T. _____ R. _____	_____
	S. _____ T. _____ R. _____	_____
4. Lot No. _____, Recorded Plat _____		
5. Private Claims _____		

STATE OF MICHIGAN
 MIDLAND COUNTY
 RECORDED
 12/7/1999 2:59:31 PM
 SCOTT I. HAINES
 REGISTER OF DEEDS

Register of Deeds Stamp & File Number

I, Mark R. Robison, in a field survey on 6-28-1999, do hereby certify that under requirements of P.A. 74, Michigan P.A. of 1970, the corner points mentioned in lines 1 and 2 above were in conformance with regulations and rules therefore as required in the current manual of survey instructions of the United States Department of the Interior, Bureau of Land Management or by a decree of a Court of Law and/or that the corner points mentioned in lines 3, 4 and 5 above were in conformance with the rules of the Michigan Board of Land Surveyors or by a Decree of a Court of Law established, re-established, monumented, re-monumented, recovered, found as expressed below.

	A	B	C	D	E	F	G	H	I	J	K	L	M
1													
2	6	5	4	3	2	1							
3													
4	7	8	9	10	11	12							
5													
6	18	17	16	15	14	13							
7													
8	19	20	21	22	23	24							
9													
10	30	29	28	27	26	25							
11													
12	31	32	33	34	35	36							
13													

NOTE: Not more than 2 corners, all in the same town and range, may be recorded on this certificate.

A. Description of original monument and accessories and/or subsequent restoration:

1852 Burt
 N89-21W, 40.06 Old gr. Corner. Set Post
 N89-24W, 79.47 Sec. Corner
 Beech 8 S71E 14
 Maple 12 N21W 30

1909 Gibbs
 Post Stone around. Old Corner
 Meas. 39.96 West & 40.10 East

1972 Whittier, (132), 1-128
 Fd 3/4" rod. Set Mon Box
 N45E 52.35, N & D in S.Side Birch Clump
 N50W 36.0, Top. E. end conc. drive, culvert

1972 Whittier, LCRC, 184
 Same as (132) 1-128

Gilbert (132)
 1/2" rod in Monument Box
 Same witnesses as (132) 1-128

1989 Lapham, LCRC, 676
 Fd 3/8" iron
 N50E 52.47 Quad Birch
 S55E 52.97 5" Pine
 N35W 45.4 6" Spruce

SURVEY &
 REMONUMENTATION

FEB 25 2000

SECTION

B. Description of corner evidence found and/or method applied in restoring or re-establishing corner:

Fd 3/8" x 18" re-rod in Mon. Box under asphalt pvm't. Fd two 1989 witnesses but did not use for new witnesses (one in yard & one close to road). One 1989 witness is same as 1972 witness but gone. Meas. West 2645.0 (GLO 2601.06) to K-11 and East 2639.56 (GLO 2643.96) to M-11. 1/6 lines and 1/4 line fences support this position.


Corner L-11, T14N, R1W was approved for remonumentation at a Peer Review Committee Meeting on 11/12/99

C. Description of monument for corner and accessories established to perpetuate locating the position of the corner:

Set 3/4" x 18" Gas Pipe with Brass Cap stamped "Midland County Remon. Cor. P.S. 27458" in Mon. Box. Accepted as best available evidence of the accepted position of the corners.

Witnesses:
 N49°W 142.25', set spike in P.P.
 S07°W 47.22 set spike in P.P.
 S20°E 78.83', set spike in 16" Pine
 N70°E 88.68', set spike in S. Truck (5") of triple oak

Signed by Mark R. Robison
 Surveyor's Michigan License No. 27458

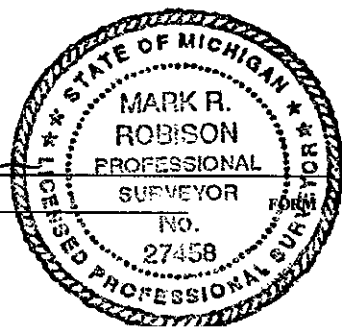

Date 12-1-99

PROVED BY MICHIGAN STATE BOARD OF LAND SURVEYORS, JAN.28. 1971