

LAND CORNER RECORDATION CERTIFICATE
Filing Requirement of Act 74, Mich. P.A. 1970

11/23/99 *[Signature]*

STATE OF MICHIGAN
MIDLAND COUNTY
RECORDED

12/7/1999 2:59:31 PM

SCOTT I. HAINES
REGISTER OF DEEDS

For Corners in <u>Midland</u> (County)	Located In:	Corner Code#:
1. Public Land Survey	T. <u>16N</u> R. <u>1W</u>	<u>M-11</u>
	T. _____ R. _____	_____
	T. _____ R. _____	_____
2. Public Controlling in Section	S. _____ T. _____ R. _____	_____
	S. _____ T. _____ R. _____	_____
3. Miscellaneous Property in Section	S. _____ T. _____ R. _____	_____
	S. _____ T. _____ R. _____	_____
4. Lot No. _____, Recorded Plat		
5. Private Claims _____		

Register of Deeds Stamp & File Number

I, Mark R. Robison, in a field survey on October 28, 1999, do hereby certify that under requirements of P.A. 74, Michigan P.A. of 1970, the corner points mentioned in lines 1 and 2 above were in conformance with regulations and rules therefore as required in the current manual of survey instructions of the United States Department of the Interior, Bureau of Land Management or by a decree of a Court of Law and/or that the corner points mentioned in lines 3, 4 and 5 above were in conformance with the rules of the Michigan Board of Land Surveyors or by a Decree of a Court of Law, established, re-established, monumented, re-monumented, recovered, found as expressed below.

	A	B	C	D	E	F	G	H	I	J	K	L	M
2	6	5	4	3	2	1							
3													
4	7	8	9	10	11	12							
5													
6	18	17	16	15	14	13							
7													
8	19	20	21	22	23	24							
9													
10	30	29	28	27	26	25							
11													
12	31	32	33	34	35	36							
13													

NOTE: Not more than 2 corners, all in the same town and range, may be recorded on this certificate.

A. Description of original monument and accessories and/or subsequent restoration:

1830 Clarke
Cor. Sec 25 & 36
Pine 15" N42W 35
Pine 24" S37 1/2W 28

1909 Gibbs, CSR
Set corrugated steel bar 3/4"
by ? long in place of old post

1954 Braidwood, MSHD Field Notes
Found 3/4" deformed iron bar
N85-30E 174.37 Tag in 14" Oak
N53E 88.83 Tag in 11" Oak
N47-30W 87.90 Roofing Cap in T.P.

1978 Schafer, (132) 2-758 & LCRC #473
Fd 3/4" Pipe
N45W 87.65 N & D in P.P.
S45W 34.0 C.L. South leg stop sign
19.35 W. of C.L. pvm't N & S

1981 Gilbert, (132) 3-180
N.E. Cor Sec 36, 19.58 W of C.L.

1993 Gilbert, (132) 5-09 & 5-61
3/4" pipe 19.58 W of C.L. M-30
N45W 83.48 N & D in N.W. Cor
4 x 4 Bell Marker Post
S62W 52.94 Chis. X in S. End
60" Conc Drain Culv.

1993 Ledy, (132) 5-205
Same as (132) 2-758

SURVEY &
REMONUMENTATION

FEB 25 2000

SECTION


B. Description of corner evidence found and/or method applied in restoring or re-establishing corner:

Found 3/4" x 18" pipe and Midland Co. Remon Cap in hole in asphalt 18.8' W. of C.L. M-30, and 5' N. of C.L. Fike Road. Excavated and found old Mon. Box 8" below surface of asphalt. Placed new Mon. Box inside old MSHD type Mon. Box. Did not find closing corner 446.82' North. Did not find MSHD witnesses. Meas. S 2636.4' to M-12,

C. Description of monument for corner and accessories established to perpetuate locating the position of the corner:

Witnesses:
S72°W, 53.12 Top Cen. 48" Conc. Culv. (OBT)
N50°W, 83.46 N & T in Tel. riser guard post (OBT)
N12°W, 131.56 N & T in 10" x 8" x 7" Tr. Ash
N85°E, 96.04 N & T in P.P.

Signed by Mark R. Robison
Surveyor's Michigan License No. 27458

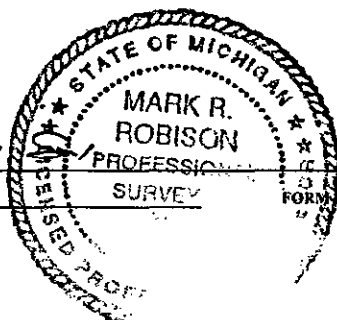

Date 11-29-99