

JAN 21 1999

APPROVED BY HUNTER
P.A. 345 OF 1990
MIDLAND COUNTY

REMON. COR. A-9, MILLS TWP.
LAND CORNER RECORDATION CERTIFICATE SECTION
Filing Requirement of Act 74, Mich. P.A. 1970

413

For corners in
Midland
(County)

1. Public Land Survey Located in: T 16N R 2E Corner Code # A-9
2. Property Controlling in Section S T R
3. Miscellaneous Property in Sec. S T R
4. Lot No. _____, Recorded Plat _____
5. Private Claims _____

STATE OF MICHIGAN
MIDLAND COUNTY
REMONUMENTATION & FILED

12/16/1998 12:11:56 PM

BEVERLY J. THAYER
REGISTER OF DEEDS

Register of Deeds Stamp & File Number

I, RODNEY CLAYPOOL, in a field survey on APRIL 15, 1997, do hereby certify that under requirements of P.A. 74, Michigan P.A. of 1970, the corner points mentioned on lines 1 and 2 above were in conformance with regulations and rules therefore as required in the current manual of survey instructions of the United States Department of the interior, Bureau of Land Management or by a decree of a Court of Law and/or that the corner points mentioned in lines 3, 4 and 5 above were in conformance with the rules of the Michigan Board of Land Surveyors or by a Decree of a Court of Law; re-established, monumented, re-monumented, recovered, found as expressed below:


NOTE: Not more than 2 corners, all in the same town and range, may be recorded on this certificate.

	A	B	C	D	E	F	G	H	I	J	K	L	M
2	6	5	4	3	2	1							
3													
4	7	8	9	10	11	12							
5													
6	18	17	16	15	14	13							
7													
8	19	20	21	22	23	24							
9													
10	30	29	28	27	26	25							
11													
12	31	32	33	34	35	36							
13													

A. Description of original monument and accessories and/or subsequent restoration:

A-9 Corner common to Sections 19 and 30 on West Townline

Government survey, 1830, set post
Survey by F. Gibbs, iron
Notes by Hunter-Whittier, 1970, found 1" rod and stone
Survey by Edmands Engineering, 1975
Survey by Hunter-Whittier, 1977, found corner

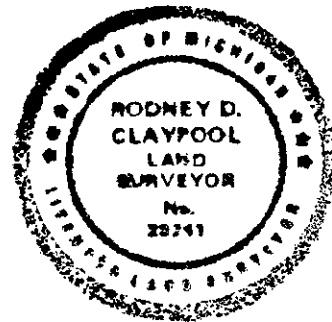

WITNESS NOTE: Witnesses from above surveys and LCRC's are available in dossier file; which was presented to peer review committee and is on file at the Register of Deeds Office.

B. Description of corner evidence found and/or method applied in restoring or reestablishing corner:

A-9 Corner common to Sections 19 and 30, on West Townline

Found 3/4" pipe and plug per surveys by F. Gibbs, Hunter-Whittier, and Edmands Engineering

Corner A-9 was approved for remonumentation at a Peer Review Committee Meeting on August 17, 1998.

C. Description of monument for corner and accessories established to perpetuate locating the position of the corner:

A-9 Corner common to Sections 19 and 30 on West Townline

Found 3/4" pipe and plug per surveys by F. Gibbs, Hunter-Whittier, and Edmands Engineering, replaced pipe with 5/8" rod and 4' long with brass cap stamped Midland Co. Remon Cor. PS 29241, and is accepted as the best available evidence of the position of the accepted corner.

N 80 Deg W, 35.95', nail and plastic disc in South side power pole (Rec.)
S 30 Deg W, 81.85', nail and plastic disc in 24" Maple
S 30 Deg E, 78.47', nail and plastic disc in telephone pole stub
N 35 Deg E, 161.98', nail and plastic disc in power pole
South, 23.74', Hope Twp. corner M-9 (TIGU-RIE)
South, 24', centerline East & West road

Signed by Rodney D. Claypool Date 09-11-98

Surveyor's Michigan License No. 29241