

APR 28 1995

9/27/94 JLP

LAND CORNER RECORDATION CERTIFICATE  
COMMISSION  
Filing Requirement of Act 74, Mich. P.A. 1970

STATE OF MICHIGAN  
MIDLAND COUNTY  
REMONUMENTATION & FILED

11 OCT 94 4:08 P.M.

BEVERLY J THAYER  
REGISTER OF DEEDS

For corners in

MIDLAND (County)	Located In:	Corner Code #
1. Public Land Survey	T <u>16N</u> R <u>2E</u>	<u>C-7</u>
	T _____ R _____	_____
	T _____ R _____	_____
	T _____ R _____	_____
2. Property Controlling in Section	S _____ T _____ R _____	_____
	S _____ T _____ R _____	_____
3. Miscellaneous Property in Sec.	S _____ T _____ R _____	_____
	S _____ T _____ R _____	_____
4. Lot No. _____, Recorded Plat _____		
5. Private Claims _____		

Register of Deeds Stamp & File Number

I, PAUL B. LAPHAM, in a field survey on MAY, 19 94, do hereby certify that under requirements of P.A. 74, Michigan P.A. of 1970, the corner points mentioned in lines 1 and 2 above were in conformance with regulations and rules therefore as required in the current manual of survey instructions of the United States Department of the Interior, Bureau of Land Management or by a decree of a Court of Law and/or that the corner points mentioned in lines 3, 4 and 5 above were in conformance with the rules of the Michigan Board of Land Surveyors or by a Decree of a Court of Law; established, re-established, monumented, re-monumented, recovered, found as expressed below:

**NOTE: Not more than 4 corners, all in the same town and range, may be recorded on this certificate.**

A. Description of original monument and accessories and/or subsequent restoration:

C-7: CORNER COMMON TO SECTIONS 17, 18, 19 & 20  
1831 - HARVEY PARKE TAMARACK 8", S 66°W, 50 LKS  
W. OAK 12", N 17°E, 38 LKS

NO C.S.R.

2-14-74 - PAUL B. LAPHAM, FOUND 1-1/2" PIPE IN MONUMENT BOX, L.C.R.C. #279  
N 19°E, 25.4' - EAST END 12" C.M.P.  
S 60°W, 47.5' - CORNER FENCE POST  
N 40°W, 74.1' - POWER POLE

B. Description of corner evidence found and/or method applied in restoring or reestablishing corner:


C-7: CORNER COMMON TO SECTIONS 17, 18, 19 & 20  
FOUND 3/4" x 24" PIPE OVER 1/2" x 12" RE-ROD OVER 1" x 18" PIPE WITH A WOODEN HUB BESIDE IT.  
THEY WERE ALL VERY CLOSE IN LINE VERTICALLY IN MONUMENT BOX  
FOUND RECORDED WITNESSES #1, #2 & #3, AS NOTED ABOVE

Accepted as best available evidence of the position of the original corner & replaced with Standard Monument.

Corner C-7 was approved for remonumentation at a Peer Review Committee Meeting on 9-27, 1994.

C. Description of monument for corner and accessories established to perpetuate locating the position of the corner:

C-7: 1/4 Corner common to Section 3, 4, 9 and 10  
Set 5/8" x 36" re-rod with brass cap stamped "Midland Co. Remon. Cor. PS 9433" in Mon. Box.  
N 19°E, 25.4' - EAST END 12" C.M.P. (#1)  
S 60°W, 47.5' - NAIL & DISK IN CORNER FENCE POST (#2)  
N 40°W, 74.1' - NAIL & DISK IN POWER POLE (#3)  
N 30°E, 35.30' - NAIL & DISK IN POWER POLE  
S 43°W, 65.10' - NAIL & DISK IN POWER POLE

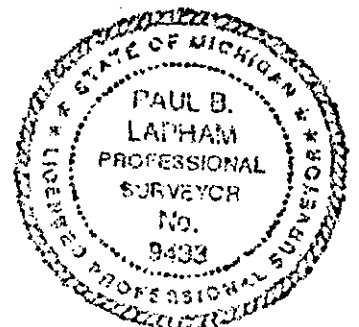

Signed by Paul B. Lapham

Date 9-30-94

Surveyor's Michigan License No. 9433