

JAN 21 1999

APPROVED LAND CORNER
P.A. 345 OF 1990
MIDLAND COUNTY

REMON. COR. E-1, MILLS TWP. SECTION
LAND CORNER RECORDATION CERTIFICATE
Filing Requirement of Act 74, Mich. P.A. 1970

410

For corners in
Midland

(County)

Located in: Corner Code #

- 1. Public Land Survey T 16N R 2E E-1
T ___ R ___
T ___ R ___
T ___ R ___
- 2. Property Controlling S ___ T ___ R ___
In Section S ___ T ___ R ___
- 3. Miscellaneous S ___ T ___ R ___
Property in Sec. S ___ T ___ R ___
- 4. Lot No. _____, Recorded Plat _____
- 5. Private Claims _____

STATE OF MICHIGAN
MIDLAND COUNTY
REMONUMENTATION & FILED

12/16/1998 12:11:56 PM

BEVERLY J. THAYER
REGISTER OF DEEDS

Register of Deeds Stamp & File Number

I, RODNEY CLAYPOOL, in a field survey on DECEMBER 6, 1998, do hereby certify that under requirements of P.A. 74, Michigan P.A. of 1970, the corner points mentioned on lines 1 and 2 above were in conformance with regulations and rules therefore as required in the current manual of survey instructions of the United States Department of the interior, Bureau of Land Management or by a decree of a Court of Law and/or that the corner points mentioned in lines 3, 4 and 5 above were in conformance with the rules of the Michigan Board of Land Surveyors or by a Decree of a Court of Law; re-established, monumented, re-monumented, recovered, found as expressed below:

NOTE: Not more than 2 corners, all in the same town and range, may be recorded on this certificate.


	A	B	C	D	E	F	G	H	I	J	K	L	M
2	6	5	4	3	2	1							
3													
4	7	8	9	10	11	12							
5													
6	18	17	16	15	14	13							
7													
8	19	20	21	22	23	24							
9													
10	30	29	28	27	26	25							
11													
12	31	32	33	34	35	36							
13													

A. Description of original monument and accessories and/or subsequent restoration:

E-1 Corner common to Sections 4 and 5 on North Townline

Government survey, 1830's, set post
Survey by DNR, 1971, found post, set DNR mon

WITNESS NOTE: Witnesses from above surveys and LCRC's are available in dossier file; which was presented to peer review committee and is on file at the Register of Deeds Office.

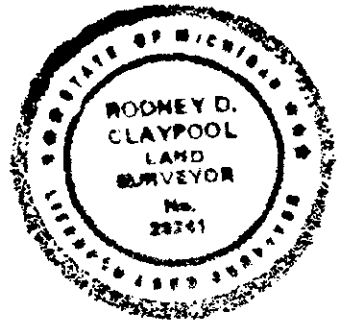

B. Description of corner evidence found and/or method applied in restoring or reestablishing corner:

E-1 Corner common to Sections 4 and 5, on North Townline

Found DNR mon per DNR survey

Corner E-1 was approved for remonumentation at a Peer Review Committee Meeting on August 17, 1998.

C. Description of monument for corner and accessories established to perpetuate locating the position of the corner:

E-1 Corner common to Sections 4 and 5 on North Townline

Found DNR mon, 1" pipe with 4" aluminum cap stamped Department of Conservation Michigan State Forest T16N 5|4 R2E, and is accepted as the best available evidence of the position of the accepted corner.

N 40 Deg W, 3.52', nail and plastic disc in 8" Maple
S 70 Deg E, 24.83', nail and plastic disc in 18" Maple
N 70 Deg E, 48.22', nail and plastic disc in 12" Ash
N 20 Deg W, 27.40', nail and plastic disc in 15" Maple

Signed by Rodney D. Claypool

Date 09-11-98

Surveyor's Michigan License No. 29241