

NOV 1995

APPROVED LAND CORNER  
P.A. 345 OF 1990  
MIDLAND COUNTY

*4/25/95 JSC*

COMMISSION  
REMON. COR. G-3, MILLS TOWNSHIP  
LAND CORNER RECORDATION CERTIFICATE  
Filing Requirement of Act 74, Mich. P.A. 1970

211

For corners in  
Midland

(County)

Located In: Corner Code #

- 1. Public Land Survey T 16N R 2E G-3  
T \_\_\_ R \_\_\_  
T \_\_\_ R \_\_\_  
T \_\_\_ R \_\_\_
- 2. Property Controlling S \_\_\_ T \_\_\_ R \_\_\_  
in Section S \_\_\_ T \_\_\_ R \_\_\_
- 3. Miscellaneous S \_\_\_ T \_\_\_ R \_\_\_  
Property in Sec. S \_\_\_ T \_\_\_ R \_\_\_
- 4. Lot No. \_\_\_\_\_, Recorded Plat \_\_\_\_\_
- 5. Private Claims \_\_\_\_\_

STATE OF MICHIGAN  
MIDLAND COUNTY  
FILED

11 MAY 95 3:18 P.M.

BEVERLY J THAYER  
REGISTER OF DEEDS

Register of Deeds Stamp & File Number

I, RODNEY CLAYPOOL, in a field survey on FEBRUARY 8, 1994, do hereby certify that under requirements of P.A. 74, Michigan P.A. of 1970, the corner points mentioned on lines 1 and 2 above were in conformance with regulations and rules therefore as required in the current manual of survey instructions of the United States Department of the Interior, Bureau of Land Management or by a decree of a Court of Law and/or that the corner points mentioned in lines 3, 4 and 5 above were in conformance with the rules of the Michigan Board of Land Surveyors or by a Decree of a Court of Law; re-established, monumented, re-monumented, recovered, found as expressed below:

**NOTE: Not more than 4 corners, all in the same town and range, may be recorded on this certificate.**

	A	B	C	D	E	F	G	H	I	J	K	L	M
2	6	5	4	3	2	1							
3													
4	7	8	9	10	11	12							
5													
6	18	17	16	15	14	13							
7													
8	19	20	21	22	23	24							
9													
10	30	29	28	27	26	25							
11													
12	31	32	33	34	35	36							
13													

A. Description of original monument and accessories and/or subsequent restoration:

G-3 Corner common to Sections 3, 4, 9 and 10

Government survey 1830's, set wood post  
Pine 30", S 72 Deg E, 23 L, (15.18')  
Iron wood N 22 Deg W, 17 L (11.22')

Survey by J. Meyer, found 3/4" pipe

Survey and LCRC by P. Ciosek, 1992, found 3/4" pipe

Survey by J. Schafer, 1979, set 3/4" pipe


Survey by P. Lapham, 1985

WITNESS NOTE: Witnesses from above surveys and LCRC's are available in dossier file; which was presented to peer review committee and is on file at the Register of Deeds Office.

B. Description of corner evidence found and/or method applied in restoring or reestablishing corner:

G-3 Corner common to Sections 3, 4, 9 and 10

Found 3/4" pipe (replaced with 3/4" pipe and brass cap) per surveys by J. Schafer, P. Lapham, J. Meyers and P. Ciosek.

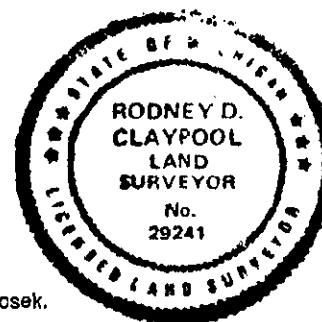

Corner G-3 was approved for remonumentation at a Peer Review Committee Meeting on April 25, 1995.

C. Description of monument for corner and accessories established to perpetuate locating the position of the corner:

G-3 Corner common to Sections 3, 4, 9 and 10

Found 3/4" pipe (replaced with 3/4" pipe and brass cap stamped Midland Co. Remon Cor. PS 29241 in mon box) per surveys by J. Schafer, P. Lapham, J. Meyers and P. Ciosek and is the best available evidence of the accepted position of the corner fence post.

- S 45 Deg E, 49.58', nail in corner fence post
- N 35 Deg W, 118.38', NE cor telephone building
- N 60 Deg W, 118.75', SW cor telephone building
- S 15 Deg W, 137.15', nail and plastic disc in 12" Pine

Signed by Rodney D. Claypool

Date 05-11-95

Surveyor's Michigan License No. 29241