

APPROVED LAND CORNER  
P.A. 345 OF 1990  
MIDLAND COUNTY

1995

COMMISSION

REMON. COR. G-4, MILLS TOWNSHIP  
LAND CORNER RECORDATION CERTIFICATE  
Filing Requirement of Act 74, Mich. P.A. 1970

212

4/25/95 JDC

For corners in  
Midland

(County)

Located in: Corner Code #

1. Public Land Survey

T 16N R 2E G-4

T R

T R

T R

2. Property Controlling  
In Section

S T R

S T R

3. Miscellaneous  
Property in Sec.

S T R

S T R

4. Lot No. \_\_\_\_\_, Recorded Plat \_\_\_\_\_

5. Private Claims \_\_\_\_\_

STATE OF MICHIGAN  
MIDLAND COUNTY  
FILED

11 MAY 95 3:18 P.M.

BEVERLY J THAYER  
REGISTER OF DEEDS

Register of Deeds Stamp & File Number

I, RODNEY CLAYPOOL, in a field survey on FEBRUARY 8, 1994, do hereby certify that under requirements of P.A. 74, Michigan P.A. of 1970, the corner points mentioned on lines 1 and 2 above were in conformance with regulations and rules therefore as required in the current manual of survey instructions of the United States Department of the Interior, Bureau of Land Management or by a decree of a Court of Law and/or that the corner points mentioned in lines 3, 4 and 5 above were in conformance with the rules of the Michigan Board of Land Surveyors or by a Decree of a Court of Law; re-established, monumented, re-monumented, recovered, found as expressed below:

**NOTE: Not more than 4 corners, all in the same town and range, may be recorded on this certificate.**

	A	B	C	D	E	F	G	H	I	J	K	L	M
2	6	5	4	3	2	1							
3													
4	7	8	9	10	11	12							
5													
6	18	17	16	15	14	13							
7													
8	19	20	21	22	23	24							
9													
10	30	29	28	27	26	25							
11													
12	31	32	33	34	35	36							
13													

A. Description of original monument and accessories and/or subsequent restoration:

G-4 Corner common to Sections 9 and 10

Government survey 1830's, set post  
Tamarack 18", N 46 Deg W, 12 L, (7.92')  
W. Oak 10", S 4 Deg E, 19 L (12.54')

Survey by J. Jones, 1988 set 3/4" pipe  
on straight line at average distance  
between G-3 and G-5


WITNESS NOTE: Witnesses from above surveys and LCRC's are available in dossier file; which was presented to peer review committee and is on file at the Register of Deeds Office.

B. Description of corner evidence found and/or method applied in restoring or reestablishing corner:

G-4 Corner common to Sections 9 and 10

Found 3/4" pipe (replaced with 3/4" pipe and brass cap) per surveys by J. Jones.

Corner G-4 was approved for remonumentation at a Peer Review Committee Meeting on April 25, 1995.

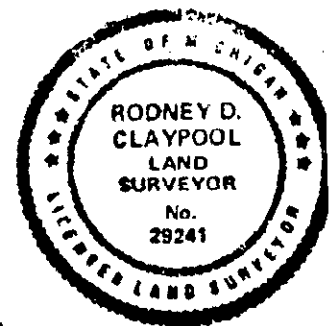

C. Description of monument for corner and accessories established to perpetuate locating the position of the corner:

G-4 Corner common to Sections 9 and 10

Found 3/4" pipe (replaced with 3/4" pipe and brass cap stamped Midland Co. Remon Cor. PS 29241 in mon box) per survey by J. Jones and is accepted as the best available evidence of the accepted position of the corner.

West 33.05', 3/4" pipe and plug #24612  
East 23.61', PK nail in 4" x 4" telephone stub  
N 60 Deg E, 32.27', nail in 8" Birch

N 50 Deg E, 44.16', nail in 6" Ash  
N 20 Deg W, 105.34', nail and plastic disc in 15" Oak  
N 40 Deg W, 74.93', nail and plastic disc in 18" Maple clump

Signed by Rodney D. Claypool

Date 05-11-95

Surveyor's Michigan License No. 29241