

APPROVED LAND CORNER  
P.A. 345 OF 1990  
MIDLAND COUNTY

11/12/96

REMON. COR. H-1, MILLS TWP.  
LAND CORNER RECORDATION CERTIFICATE  
Filing Requirement of Act 74, Mich. P.A. 1970

303

For corners in  
Midland

(County)

Located in: Corner Code #

- |                                       |                          |            |
|---------------------------------------|--------------------------|------------|
| 1. Public Land Survey                 | T <u>16N</u> R <u>2E</u> | <u>H-1</u> |
|                                       | T ___ R ___              | _____      |
|                                       | T ___ R ___              | _____      |
|                                       | T ___ R ___              | _____      |
| 2. Property Controlling<br>in Section | S ___ T ___ R ___        | _____      |
|                                       | S ___ T ___ R ___        | _____      |
| 3. Miscellaneous<br>Property In Sec.  | S ___ T ___ R ___        | _____      |
|                                       | S ___ T ___ R ___        | _____      |
| 4. Lot No. _____, Recorded Plat _____ |                          |            |
| 5. Private Claims _____               |                          |            |

STATE OF MICHIGAN  
MIDLAND COUNTY  
REMONUMENTATION & FILED

13 DEC 96 2:06 P.M.

BEVERLY J THAYER  
REGISTER OF DEEDS

Register of Deeds Stamp & File Number


I, RODNEY CLAYPOOL, in a field survey on NOV. 25, 1996, do hereby certify that under requirements of P.A. 74, Michigan P.A. of 1970, the corner points mentioned on lines 1 and 2 above were in conformance with regulations and rules therefore as required in the current manual of survey instructions of the United States Department of the Interior, Bureau of Land Management or by a decree of a Court of Law and/or that the corner points mentioned in lines 3, 4 and 5 above were in conformance with the rules of the Michigan Board of Land Surveyors or by a Decree of a Court of Law; re-established, monumented, re-monumented, recovered, found as expressed below:

**NOTE: Not more than 4 corners, all in the same town and range, may be recorded on this certificate.**

	A	B	C	D	E	F	G	H	I	J	K	L	M
2	6	5	4	3	2	1							
3													
4	7	8	9	10	11	12							
5													
6	18	17	16	15	14	13							
7													
8	19	20	21	22	23	24							
9													
10	30	29	28	27	26	25							
11													
12	31	32	33	34	35	36							
13													

A. Description of original monument and accessories and/or subsequent restoration:

- H-1 N 1/4 corner Section 3
- Not set by Government
- Survey by J. Jones, 1990, found remains of concrete cylinder and old steel door handles (about 10" deep) Raised with 3/4" pipe
- Survey and LCRC by P. Closek, 1992, found 3/4" pipe

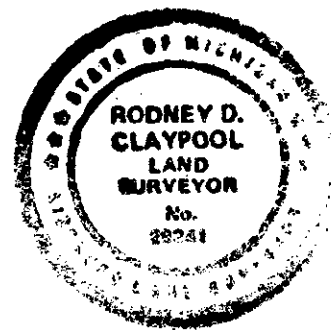

WITNESS NOTE: Witnesses from above surveys and LCRC's are available in dossier file; which was presented to peer review committee and is on file at the Register of Deeds Office.

B. Description of corner evidence found and/or method applied in restoring or reestablishing corner:

- H-1 N 1/4 corner Section 3
- Found 3/4" pipe and plug, per surveys by J. Jones, moved to controlling Bentley Township Townline, Gladwin Co.

Corner H-1 was approved for remonumentation at a Peer Review Committee Meeting on Nov. 12, 96.

C. Description of monument for corner and accessories established to perpetuate locating the position of the corner:

- H-1 N 1/4 corner Section 3
- Found 3/4" pipe per J. Jones; (reset on controlling Bentley Township Townline, Gladwin Co. with 3/4" pipe and brass cap stamped Midland Co. Remon Cor. PS 29241) and is accepted as the best available evidence of the position of the accepted corner.
- N 65 Deg W, 102.46', nail and disc in power pole  
N 70 Deg W, 85.45', notch in north end 42" CMP  
S 75 Deg W, 81.88', notch in south end 42" CMP  
South 29.50', 3/4" pipe and Ayres cap  
West 38.73', 1/2" rod H-13 T16N-R3E, Bentley Township, Gladwin County.

Signed by Rodney D. Claypool

Date 12-12-96

Surveyor's Michigan License No. 29241