

**SURVEY &  
REMONUMENTATION**

APPROVED LAND CORNER  
P.A. 345 OF 1990  
MIDLAND COUNTY

APR 28 1995

106

9/27/94 *[Signature]*

**LAND CORNER RECORDATION CERTIFICATE**  
Filing Requirement of Act 74, Mich. P.A. 1970

For corners in

MIDLAND (County)	Located In:	Corner Code #
1. Public Land Survey	T <u>16N</u> R <u>2E</u>	<u>I-11</u>
	T _____ R _____	_____
	T _____ R _____	_____
	T _____ R _____	_____
2. Property Controlling in Section	S _____ T _____ R _____	_____
	S _____ T _____ R _____	_____
3. Miscellaneous Property in Sec.	S _____ T _____ R _____	_____
	S _____ T _____ R _____	_____

STATE OF MICHIGAN  
MIDLAND COUNTY  
REMONUMENTATION & FILED

11 OCT 94 4:07 P.M.

BEVERLY J THAYER  
REGISTER OF DEEDS

Register of Deeds Stamp & File Number

1. Lot No. \_\_\_\_\_, Recorded Plat \_\_\_\_\_  
2. Private Claims \_\_\_\_\_

	A	B	C	D	E	F	G	H	I	J	K	L	M
2	6		5		4		3		2		1		
3													
4	7		8		9		10		11		12		
5													
6	18		17		16		15		14		13		
7													
8	19		20		21		22		23		24		
9													
10	30		29		28		27		26		25		
11													
12	31		32		33		34		35		36		
13													

I, Paul B. Lapham, in a field survey on MAY, 19 94,  
do hereby certify that under requirements of P.A. 74, Michigan P.A. of 1970, the corner points mentioned  
in lines 1 and 2 above were in conformance with regulations and rules therefore as required in the  
current manual of survey instructions of the United States Department of the Interior, Bureau of Land  
Management or by a decree of a Court of Law and/or that the corner points mentioned in lines 3, 4 and 5  
above were in conformance with the rules of the Michigan Board of Land Surveyors or by a Decree of a  
Court of Law; established, re-established, monumented, re-monumented, recovered, found as  
expressed below:

**NOTE: Not more than 4 corners, all in the same town and range, may be recorded  
on this certificate.**

1. Description of original monument and accessories and/or subsequent restoration:

- I-11: Corner common to Sections 26, 27, 34 and 35  
1831 - Harvey Parke Maple 12" N 48°E, 9 lks - Maple 12" S 42°W, 12 lks  
No C.S.R.
- 6-26-71 - Alva Courtright, Found 3/4" Pipe 3" deep, L.C.R.C. #105  
1. NW, 44.9' T.P. 2. N 32.2' Wood Post 3. SE 23.5' 12" Tube 4. SW 22.2' 12" Tube  
5. SW 60.25' P.P.
- 6-19-72 - Arthur Leach 2. N 32.5' S. Face Fence Post (132) 1-160  
6. N 30°W, 58.0' Face P.P. 5. S 40°W 60.80' N Face P.P.
- 3-18-76 - Thomas O'Brien C.S.R. 2-267-273  
5. Power Pole S 40°W, 60.4' 7. Power Pole N 30°E, 45.0' 2. Fence Post NORTH 31.9'

1. Description of corner evidence found and/or method applied in restoring or reestablishing corner:


- I-11: Corner common to Sections 26, 27, 34 and 35  
Found 3/4" Pipe over 1/2" Rod over Pinch Pipe in Monument Box.  
Excavated to 3' depth did not find further evidence.  
Found recorded witness #5.  
Meas. 5285.73 to K-11 (Unrecorded 1977 notes by Paul B. Lapham show 5285.43')  
(See Rec. Survey Liber 2, Pg 514 for E 1/2. S 1/4 Corner set single proportionate measure per notes.)

Accepted as best available evidence of the position of the original corner & replaced with Standard Monument.

Corner I-11 was approved for remonumentation at a Peer Review Committee Meeting on 9-27, 19 94

Description of monument for corner and accessories established to perpetuate locating the position of the corner:

- I-11: Corner common to Sections 26, 27, 34 and 35  
Set 5/8" x 36" re-rod with brass cap stamped "Midland Co. Remon. Cor. PS 9433" in Mon. Box.  
S 40°W, 60.25' - Power Pole (5) Nail & Tag  
N 60°W, 62.5' - 16" Elm - Nail & Tag  
S 45°W, 41.5' - Corner Post - Nail & Tag  
N 25°W, 45.5' - Tele. Riser

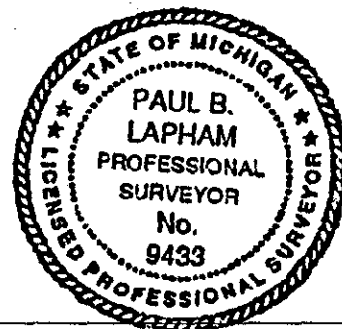

Signed by Paul B. Lapham

Date 9-30-94

Surveyor's Michigan License No. 9433