

APPROVED LAND CORNER
P.A. 345 OF 1990
MIDLAND COUNTY

REMON. COR. I-13, MILLS TWP.
LAND CORNER RECORDATION CERTIFICATE
Filing Requirement of Act 74, Mich. P.A. 1970

For corners in
Midland
(County)

- | | | |
|---------------------------------------|----------------------------|-------------|
| 1. Public Land Survey | T <u>16</u> N R <u>2</u> E | <u>I-13</u> |
| | T ___ R ___ | _____ |
| | T ___ R ___ | _____ |
| | T ___ R ___ | _____ |
| 2. Property Controlling
In Section | S ___ T ___ R ___ | _____ |
| | S ___ T ___ R ___ | _____ |
| 3. Miscellaneous
Property in Sec. | S ___ T ___ R ___ | _____ |
| | S ___ T ___ R ___ | _____ |
| 4. Lot No. _____, Recorded Plat _____ | | |
| 5. Private Claims _____ | | |

332

STATE OF MICHIGAN
MIDLAND COUNTY
REMONUMENTATION & FILED

8 DEC 97 11:06 A.M.

BEVERLY J THAYER
Register of Deeds State of Michigan

I, RODNEY CLAYPOOL, in a field survey on MAY 9, 1996, do hereby certify that under requirements of P.A. 74, Michigan P.A. of 1970, the corner points mentioned on lines 1 and 2 above were in conformance with regulations and rules therefore as required in the current manual of survey instructions of the United States Department of the Interior, Bureau of Land Management or by a decree of a Court of Law and/or that the corner points mentioned in lines 3, 4 and 5 above were in conformance with the rules of the Michigan Board of Land Surveyors or by a Decree of a Court of Law; re-established, monumented, re-monumented, recovered, found as expressed below:

NOTE: Not more than 2 corners, all in the same town and range, may be recorded on this certificate.

	A	B	C	D	E	F	G	H	I	J	K	L	M
2	6	5	4	3	2	1							
3													
4	7	8	9	10	11	12							
5													
6	18	17	16	15	14	13							
7													
8	19	20	21	22	23	24							
9													
10	30	29	28	27	26	25							
11													
12	31	32	33	34	35	36							
13													


A. Description of original monument and accessories and/or subsequent restoration:

I-13 Corner common to Sections 34 and 35 on south line of T16N-R2E
1831, government survey by R. Clark, set corner

WITNESS NOTE: Witnesses from above surveys and LCRC's are available in dossier file; which was presented to peer review committee and is on file at the Register of Deeds Office.

B. Description of corner evidence found and/or method applied in restoring or reestablishing corner:

I-13 Corner common to Sections 34 and 35 on townline
Found 1/2" rod and Ledy cap. Set in Ledy survey 1994 on line and at GLO dist between I-1 and J-1, T15N-R2E
I-1 set by Ayres Associates on SPM in 1982 survey

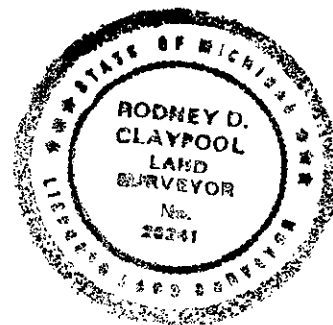

Corner I-13 was approved for remonumentation at a Peer Review Committee Meeting on 8/08/97.

C. Description of monument for corner and accessories established to perpetuate locating the position of the corner:

I-13 Corner common to Sections 34 and 35 on townline
Found 1/2" rod and Ledy cap, replaced with 3/4" pipe 4' long and brass cap stamped Midland Co. Remon Cor. PS 29241, per survey by D. Ledy and is the best available evidence of the position of the accepted corner.
N 88 Deg W, 9.87', nail in 10" twin Maple (R) No occupation evident at corner.
S 5 Deg W, 18.17', nail in 24" Maple clump (R)
S 45 Deg E, 23.51', nail in 8" Maple (R)
S 50 Deg W, 54.88', nail in 12" Maple
West, 55.44' (0.84 CHS to I-1, T15N-R2E) (R)
55.20' M

Signed by Rodney D. Claypool Date 11-26-97

Surveyor's Michigan License No. 29241

Form approved by Michigan State Board of Land Surveyors, Jan. 28, 1971

SURVEY &
REMONUMENTATION

Revised May 14, 1971
Revised Jan., 1983

FEB 24 1998

SECTION