

**SURVEY &  
REMONUMENTATION**

APR 28 1995

**APPROVED LAND CORNER  
P.A. 345 OF 1990  
MIDLAND COUNTY**

**COMMISSION**  
REMON. COR. K-13, MILLS TOWNSHIP  
**LAND CORNER RECORDATION CERTIFICATE**  
Filing Requirement of Act 74, Mich. P.A. 1970

**169**

For corners in  
Midland  
(County)

1. Public Land Survey	Located in:	Corner Code #
	T <u>16N</u> R <u>2E</u>	<u>K-13</u>
	T ___ R ___	_____
	T ___ R ___	_____
	T ___ R ___	_____
2. Property Controlling in Section	S ___ T ___ R ___	_____
3. Miscellaneous Property in Sec.	S ___ T ___ R ___	_____
	S ___ T ___ R ___	_____
4. Lot No. _____, Recorded Plat		
5. Private Claims _____		

STATE OF MICHIGAN  
MIDLAND COUNTY  
REMONUMENTATION & FILED  
  
12 DEC 94 9:50 A.M.  
  
BEVERLY J THAYER  
REGISTER OF DEEDS

Register of Deeds Stamp & File Number

I, RODNEY CLAYPOOL, in a field survey on March 4, 1994, do hereby certify that under requirements of P.A. 74, Michigan P.A. of 1970, the corner points mentioned on lines 1 and 2 above were in conformance with regulations and rules therefore as required in the current manual of survey instructions of the United States Department of the Interior, Bureau of Land Management or by a decree of a Court of Law and/or that the corner points mentioned in lines 3, 4 and 5 above were in conformance with the rules of the Michigan Board of Land Surveyors or by a Decree of a Court of Law; re-established, monumented, re-monumented, recovered, found as expressed below:


	A	B	C	D	E	F	G	H	I	J	K	L
2	6	5	4	3	2	1						
3												
4	7	8	9	10	11	12						
5												
6	18	17	16	15	14	13						
7												
8	19	20	21	22	23	24						
9												
10	30	29	28	27	26	25						
11												
12	31	32	33	34	35	36						
13												

**NOTE: Not more than 4 corners, all in the same town and range, may be recorded on this certificate.**

**A. Description of original monument and accessories and/or subsequent restoration:**

K-13 Corner common to Section 35 and 36 on South town line

- Government survey 1830's, set post
- Survey by J. Lansky, 1978, found PK nail
- Survey by J. Jones, 1981, found PK nail
- Survey by D. Ledy, found PK nail

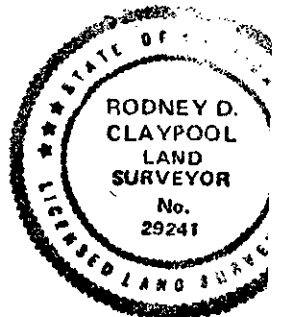

**WITNESS NOTE:** Witnesses from above surveys and LCRC's are available in dossier file; which was presented to peer review committee and is on file at the Register of Deeds Office.

**B. Description of corner evidence found and/or method applied in restoring or reestablishing corner:**

K-13 Corner common to Section 35 and 36 on South town line

Found PK nail (replaced with 5/8" rod and brass cap) per survey by J. Lansky, J. Jones, and D. Ledy. West 13.86' K-1 (Remon Cor.) T15N-R2E.

Corner K-13 was approved for remonumentation at a Peer Review Committee Meeting on Dec 1, 1994

**C. Description of monument for corner and accessories established to perpetuate locating the position of the corner:**

K-13 Corner common to Section 35 and 36 on South town line

Found PK nail (replaced with 5/8" rod and brass cap stamped Midland Co. Remon Cor. PS 29241 in mon box) per surveys by J. Lansky, J. Jones and D. Ledy and is accepted as the best available evidence of the accepted position of the corner.

- N 20 Deg W, 52.53', nail and plastic disc in power pole
- N 25 Deg W, 43.51', chiseled "+" in top of project marker
- N 50 Deg E, 107.14', nail and plastic disc in 15" Apple

- S 45 Deg W, 73.75', nail and disc in power pole
- East, 5.3', centerline Waldo Road

Signed by Rodney D. Claypool

Date 12-09-94

Surveyor's Michigan License No. 29241

Form approved by Michigan State Board of Land Surveyors, Jan. 28, 1971

Revised May 14, 1971

Revised Jan. 1983