

**SURVEY &  
REMONUMENTATION**

**APPROVED LAND CORNER  
P.A. 345 OF 1990  
MIDLAND COUNTY**

APR 28 1995

COMMISSION

**153**

*11/23/94 JBL*

**LAND CORNER RECORDATION CERTIFICATE  
Filing Requirement of Act 74, Mich. P.A. 1970**

STATE OF MICHIGAN  
MIDLAND COUNTY  
REMONUMENTATION & FILED

7 DEC 94 8:24 A.M.

BEVERLY J THAYER  
REGISTER OF DEEDS

Register of Deeds Stamp & File Number

For corners in

| MIDLAND<br>(County)                   | Located In:              | Corner Code # |
|---------------------------------------|--------------------------|---------------|
| 1. Public Land Survey                 | T <u>16N</u> R <u>2E</u> | <u>M-11</u>   |
|                                       | T _____ R _____          | _____         |
|                                       | T _____ R _____          | _____         |
|                                       | T _____ R _____          | _____         |
| 2. Property Controlling<br>in Section | S _____ T _____ R _____  | _____         |
|                                       | S _____ T _____ R _____  | _____         |
| 3. Miscellaneous<br>Property in Sec.  | S _____ T _____ R _____  | _____         |
|                                       | S _____ T _____ R _____  | _____         |

4. Lot No. \_\_\_\_\_, Recorded Plat \_\_\_\_\_  
5. Private Claims \_\_\_\_\_

I, PAUL B. LAPHAM, in a field survey on JUNE, 19 94, do hereby certify that under requirements of P.A. 74, Michigan P.A. of 1970, the corner points mentioned in lines 1 and 2 above were in conformance with regulations and rules therefore as required in the current manual of survey instructions of the United States Department of the Interior, Bureau of Land Management or by a decree of a Court of Law and/or that the corner points mentioned in lines 3, 4 and 5 above were in conformance with the rules of the Michigan Board of Land Surveyors or by a Decree of a Court of Law; established, re-established, monumented, re-monumented, recovered, found as expressed below:

**NOTE: Not more than 4 corners, all in the same town and range, may be recorded on this certificate.**

|    | A  | B  | C  | D  | E  | F | G | H | I | J | K | L |
|----|----|----|----|----|----|---|---|---|---|---|---|---|
| 2  | 6  | 5  | 4  | 3  | 2  |   |   |   |   |   |   |   |
| 3  |    |    |    |    |    |   |   |   |   |   |   |   |
| 4  | 7  | 8  | 9  | 10 | 11 |   |   |   |   |   |   |   |
| 5  |    |    |    |    |    |   |   |   |   |   |   |   |
| 6  | 18 | 17 | 16 | 15 | 14 |   |   |   |   |   |   |   |
| 7  |    |    |    |    |    |   |   |   |   |   |   |   |
| 8  | 19 | 20 | 21 | 22 | 23 |   |   |   |   |   |   |   |
| 9  |    |    |    |    |    |   |   |   |   |   |   |   |
| 10 | 30 | 29 | 28 | 27 | 26 |   |   |   |   |   |   |   |
| 11 |    |    |    |    |    |   |   |   |   |   |   |   |
| 12 | 31 | 32 | 33 | 34 | 35 |   |   |   |   |   |   |   |
| 13 |    |    |    |    |    |   |   |   |   |   |   |   |

**A. Description of original monument and accessories and/or subsequent restoration:**

M-11: 25-36 SEC. CORNER ON TWP. LINE  
1831 HARVEY PARKE  
WIT.- B. ASH 10" S 48°W 18 LKS.  
WIT.- B. ASH 6" N 32-1/2°W 20 LKS.

NO C.S.R.

7-17-71 ALVA COURTWRIGHT L.C.R.C. #106  
3/4 STEEL ROD SET PER B.L.M. REQUIREMENTS. (SKETCH INDICATES SAME)  
WIT.- (1)54' N OF C OF OLD BRIDGE  
(2)65' NW OF CORNER FENCE POST  
(3)53.4' SE OF TP  
(4)62.7' SE OF TP  
(5)COUNTY LINE ABOUT 1' W OF E RAIL OF OLD BRIDGE

8-19-74 PAUL LAPHAM (132)1-706  
FOUND 5/8" BAR IN MON. BOX  
WIT.- (2)S 22°E 65.54' CORNER FENCE POST  
(6)S 57°W 62.31' POWER POLE  
(7)S 62°W 39.71' CORNER FENCE POST

11-6-74 PAUL LAPHAM LCRC #332  
FOUND 5/8" BAR IN MON. BOX.  
WIT.- 2,6, & 7 ABOVE

**B. Description of corner evidence found and/or method applied in restoring or reestablishing corner:**


M-11: 25-36 SEC. CORNER ON TWP. LINE  
Found 3/4" X 18" Iron in Monument Box. Excavated to depth of 3', did not find further evidence.  
Found recorded witness #6, as noted above.  
Found 5/8" Bar on line 10.56' South of Iron in Mon. Box. (Bay County Sec. Cor. per LCRC #106)  
Found 3/4" X 18" Iron Pipe in C of E-W asphalt and 8.15' N 18°E of iron in Mon. Box.  
Accepted Iron in Monument Box as Corner M-11.

Accepted as best available evidence of the position of the original corner & replaced with Standard Monument.

Corner M-11 was approved for remonumentation at a Peer Review Committee Meeting on 11-28, 19 94.

**C. Description of monument for corner and accessories established to perpetuate locating the position of the corner:**

M-11: 25-36 SEC. CORNER ON TWP. LINE  
Set 5/8" x 36" re-rod with brass cap stamped "Midland Co. Remon. Cor. PS 9433" in Mon. Box.  
S 57°W, 62.31' - Nail & Disk in Power Pole(6)  
S 25°E, 34.05' - Nail & Disk in Guard Rail  
N 30°W, 52.38' - Nail & Disk in 6" X 6" Post  
S 25°W, 39.25' - Nail & Disk in Guard Rail

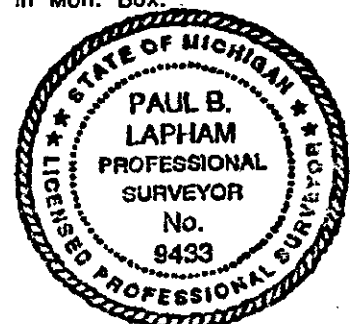

Signed by Paul B. Lapham

Date 12-01-94

Surveyor's Michigan License No. 9433