

**SURVEY &  
REMONUMENTATION**

JAN 21 1999

APPROVED LAND CORNER  
P.A. 345 OF 1990  
MIDLAND COUNTY

REMON. COR. M-12, MILLS TWP.  
**LAND CORNER RECORDATION CERTIFICATE**  
Filing Requirement of Act 74, Mich. P.A. 1970

409

For corners in  
Midland  
(County)

- |                                       |                            |             |
|---------------------------------------|----------------------------|-------------|
| 1. Public Land Survey                 | T <u>16</u> N R <u>2</u> E | <u>M-12</u> |
|                                       | T ___ R ___                | _____       |
|                                       | T ___ R ___                | _____       |
|                                       | T ___ R ___                | _____       |
| 2. Property Controlling<br>in Section | S ___ T ___ R ___          | _____       |
|                                       | S ___ T ___ R ___          | _____       |
| 3. Miscellaneous<br>Property in Sec.  | S ___ T ___ R ___          | _____       |
|                                       | S ___ T ___ R ___          | _____       |
| 4. Lot No. _____, Recorded Plat _____ |                            |             |
| 5. Private Claims _____               |                            |             |

STATE OF MICHIGAN  
MIDLAND COUNTY  
REMONUMENTATION & FILED

12/16/1998 12:11:56 PM

BEVERLY J. THAYER  
REGISTER OF DEEDS

Register of Deeds Stamp & File Number


I, JERRY JONES, in a field survey on OCT 21, 1996, do hereby certify that under requirements of P.A. 74, Michigan P.A. of 1970, the corner points mentioned on lines 1 and 2 above were in conformance with regulations and rules therefore as required in the current manual of survey instructions of the United States Department of the Interior, Bureau of Land Management or by a decree of a Court of Law and/or that the corner points mentioned in lines 3, 4 and 5 above were in conformance with the rules of the Michigan Board of Land Surveyors or by a Decree of a Court of Law; re-established, monumented, re-monumented, recovered, found as expressed below:

**NOTE: Not more than 4 corners, all in the same town and range, may be recorded on this certificate.**

	A	B	C	D	E	F	G	H	I	J	K	L	M
2	6	5	4	3	2	1							
3													
4	7	8	9	10	11	12							
5													
6	18	17	16	15	14	13							
7													
8	19	20	21	22	23	24							
9													
10	30	29	28	27	26	25							
11													
12	31	32	33	34	35	36							
13													

**A. Description of original monument and accessories and/or subsequent restoration:**

M-12 ~~West~~ <sup>EAST</sup> 1/4 Corner, Section 36  
Corner Common to A-12, T16N-R3E Bay Co. remon corner L-3, Page 301  
1831, R. Clark, set post, GLO notes  
1967, Edmands Engineering breakdown Section 31, set iron on remains of cedar post  
1974, Survey by P. Lapham, L. 1, P. 706 (Midland Co.) set 1/2" re-rod  
1994, Survey by J. Jones, L. 5, P. 91 (Midland Co.) found 1/2" re-rod

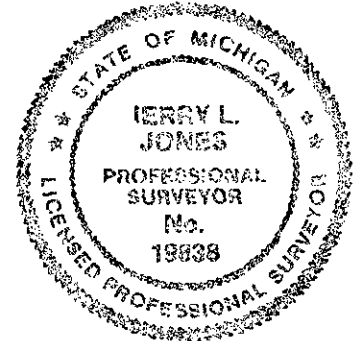

**B. Description of corner evidence found and/or method applied in restoring or reestablishing corner:**

M-12 ~~West~~ <sup>EAST</sup> 1/4 Corner, Section 36  
Corner Common to A-12, T16N-R3E  
Found Bay Co. remon corner as recorded in Bay Co. remon L003, P-301

**C. Description of monument for corner and accessories established to perpetuate locating the position of the corner:**

M-12 West 1/4 Corner, Section 36  
Corner Common to A-12, T16N-R3E  
Found 5/8" re-rod and Bay County brass cap stamped Bay County Remonumentation PS 19838 as recorded remon L003, P-301, in mon box and is accepted as the best available evidence of the position of the accepted corner.  
S 88 Deg E, 35.9', nail in fence post  
N 88 Deg W, 49.12', nail in power pole  
S 60 Deg W, 30.66', nail in 8" Ash  
S 30 Deg W, 44.97', nail in 8" Elm  
S 45 Deg W, 21.09', nail in 6" Ash  
S 15 Deg W, 44.38', nail in 6" Ash  
East 3.0', centerline North & South road

Signed by Jerry L. Jones Date SEPT. 11, 1998

Surveyor's Michigan License No. 19838