

**SURVEY &
REMONUMENTATION**

**APPROVED LAND CORNER
P.A. 345 OF 1990
MIDLAND COUNTY**

APR 28 1995

94

9/21/94 gld

**LAND CORNER RECORDATION CERTIFICATE
Filing Requirement of Act 74, Mich. P.A. 1970**

For corners in

<u>MIDLAND</u> (County)	Located in:	Corner Code #	
1. Public Land Survey	T <u>16N</u> R <u>2W</u>	<u>A-7</u>	
	T _____ R _____	_____	
	T _____ R _____	_____	
	T _____ R _____	_____	
2. Property Controlling in Section	S _____ T _____ R _____	_____	
	S _____ T _____ R _____	_____	
3. Miscellaneous Property in Sec.	S _____ T _____ R _____	_____	
	S _____ T _____ R _____	_____	
4. Lot No. _____, Recorded Plat _____			
5. Private Claims _____			

STATE OF MICHIGAN
MIDLAND COUNTY
FILED *REMON*

28 SEP 94 3:31 P.M.

BEVERLY J THAYER
REGISTER OF DEEDS

Register of Deeds Stamp & File Number

I, PAUL B. LAPHAM, in a field survey on JULY, 19 94, do hereby certify that under requirements of P.A. 74, Michigan P.A. of 1970, the corner points mentioned in lines 1 and 2 above were in conformance with regulations and rules therefore as required in the current manual of survey instructions of the United States Department of the Interior, Bureau of Land Management or by a decree of a Court of Law and/or that the corner points mentioned in lines 3, 4 and 5 above were in conformance with the rules of the Michigan Board of Land Surveyors or by a Decree of a Court of Law; established, re-established, monumented, re-monumented, recovered, found as expressed below:

A	B	C	D	E	F	G	H	I	J	K	L	M
2	6	5	4	3	2	1						
3												
4	7	8	9	10	11	12						
5												
6	18	17	16	15	14	13						
7												
8	19	20	21	22	23	24						
9												
10	30	29	28	27	26	25						
11												
12	31	32	33	34	35	36						
13												

NOTE: Not more than 4 corners, all in the same town and range, may be recorded on this certificate.

A. Description of original monument and accessories and/or subsequent restoration:

A-7: Section Corner on Township line common to Sections 18 & 19
 1832 - Jack Wright, Beech 10" N 40°E 41 lks, Beech 8" S 63°E 13 lks
 29/AUG/1900 - Gibbs, Post w/iron & crockery around, Set new Post C.S.R. 1-7
 10/18/74 - Paul Lapham, Fd 1/4" x 1" Flat Iron, Set 1/2" Capped Iron (132) 1-716
 (1) S 60°W, 63.98' - 8" Pine (2) N 15°W, 40.64' - N. "I-beam" post for guard rail
 (3) S 50°E, 83.45' - Power Pole
 11/06/74 - Paul Lapham, Witnessed as above, L.C.R.C. 11-12-74
 02/03/78 - Leonard Urbaniak, Fd. 1/2" Capped Iron, Witnessed as above, (132) 2-481
 06/13/78 - Paul Lapham, Fd 1/2" Capped Iron, Witnessed as above, (132) 2-732
 11/21/79 - Paul Lapham, Fd 1/2" Capped Iron, Witnessed as above, (132) 12-13-79
 Paul Lapham & Associates file, unrecorded field notes
 U.S.-10 Highway Plans, R/W maps
 Sept. 1973, Jerome Schafer, Survey in Sec. 13, T16N,R3W, SE. Cor. Sec. 13, 9.20' N of NW Cor. Sec. 19.

3. Description of corner evidence found and/or method applied in restoring or reestablishing corner:


A-7: Section Corner on Township line common to Sections 18 & 19
 Found Axe-head, large pointed stone, 1/4" x 1" Flat Iron (Drag Tooth) & 1/2" x 18" Iron at corner.
 Set 5/8" x 18" Iron W/Monument Cap over 1/2" x 18" Iron and replaced all previous evidence at corner.
 Also found small gage R.R. Iron, 9.24 feet North of Corner, W/ 1/2" Square Bar 0.55' East of R.R. Iron.
 Found pieces of Crockery and 2" x 4" pieces of metal between both. Found Boat Spike 1.5' S. of R.R. Iron.
 Measured East 2618.46' (Rec. 2618.30') to N 1/4 Corner. Meas. South 5262.50' (Prev. Meas. 5262.70')
 to SW Cor. Section 19.
 Found Recorded Witness (3).

Accepted as best available evidence of the position of the original corner & replaced with Standard Monument.

Corner, A-7 was approved for remonumentation at a Peer Review Committee Meeting on SEP. 21, 1994.

C. Description of monument for corner and accessories established to perpetuate locating the position of the corner:

A-7: Section Corner on Township line common to Sections 18 & 19
 Set 5/8" x 36" re-rod with brass cap stamped "Midland Co. Remon. Cor. PS 9433" in Monument Box.
 S 30°E, 59.85' - 10" Pine - Nail & Disc.
 NORTH, 9.24' - R.R. Iron, SE Cor. Sec. 13, T16N, R3W.
 S 50°E, 83.6' - Power Pole - Nail & Disc. (3)
 N 70°W, 44.7' - 6" Pine - Nail & Disc.
 S 68°W, 32.65' - 12" Pine - Nail & Disc.

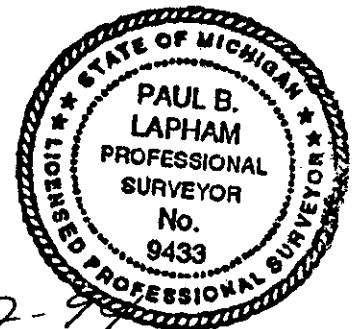

Signed by Paul B. Lapham
 Surveyor's Michigan License No. 9433

Date 9-22-94