

**SURVEY &
REMONUMENTATION**

**APPROVED LAND CORNER
P.A. 345 OF 1990
MIDLAND COUNTY**

APR 28 1995

93

**LAND CORNER RECORDATION CERTIFICATE
Filing Requirement of Act 74, Mich. P.A. 1970**

STATE OF MICHIGAN
MIDLAND COUNTY
FILED *REMON*

For corners in

MIDLAND (County)	Located In:	Corner Code #
1. Public Land Survey	T 16N R 2W	B-7
	T _____ R _____	_____
	T _____ R _____	_____
	T _____ R _____	_____
2. Property Controlling in Section	S _____ T _____ R _____	_____
	S _____ T _____ R _____	_____
3. Miscellaneous Property in Sec.	S _____ T _____ R _____	_____
	S _____ T _____ R _____	_____

28 SEP 94 3:31 P.M.

BEVERLY J THAYER
REGISTER OF DEEDS

Register of Deeds Stamp & File Number

4. Lot No. _____, Recorded Plat _____
5. Private Claims _____

	A	B	C	D	E	F	G	H	I	J	K	L	M
2	6	5	4	3	2	1							
3													
4	7	8	9	10	11	12							
5													
6	18	17	16	15	14	13							
7													
8	19	20	21	22	23	24							
9													
10	30	29	28	27	26	25							
11													
12	31	32	33	34	35	36							
13													

PAUL B. LAPHAM, in a field survey on JULY, 1994

do hereby certify that under requirements of P.A. 74, Michigan P.A. of 1970, the corner points mentioned in lines 1 and 2 above were in conformance with regulations and rules therefore as required in the current manual of survey instructions of the United States Department of the Interior, Bureau of Land Management or by a decree of a Court of Law and/or that the corner points mentioned in lines 3, 4 and 5 above were in conformance with the rules of the Michigan Board of Land Surveyors or by a Decree of a Court of Law; established, re-established, monumented, re-monumented, recovered, found as expressed below:

NOTE: Not more than 4 corners, all in the same town and range, may be recorded on this certificate.

A. Description of original monument and accessories and/or subsequent restoration:

- B-7: 1/4 Corner common to Sections 18 & 19
1832 - Jack Wright, Maple 10" N 52°E 24 lks, Hemlock 12" S 17°W 7 lks
08/29/1900 - Gibbs, Set W. Oak Post W/Stone around C.S.R. 1-7
10.18/1974 - Paul Lapham, Fd 1" Square Bar (132) 1-716
(1) S 30°W, 23.97' - 24" Oak (2) S 15°E, 21.96' - Fence Post (3) S 35°E, 40.21' - 8" Hickory
11/06/74 - Paul Lapham, Witnessed as above, L.C.R.C. 3 11-12-74
02/03/78 - Leonard Urbaniak, (PBL) Fd 1" Square Bar. Witnessed as above, (132) 2-481
11/21/79 - Paul Lapham, Fd 1" Square Bar. Witnessed as above, (132) 2-957

3. Description of corner evidence found and/or method applied in restoring or reestablishing corner:


- B-7: 1/4 Corner common to Sections 18 & 19
Found 1" x 12" Bolt. Excavated to depth of 3 feet, did not find further evidence.
Found Recorded Witnesses 1 & 3

Accepted as best available evidence of the position of the original corner & replaced with Standard Monument.

Corner, B-7 was approved for remonumentation at a Peer Review Committee Meeting on SEP. 21, 1994.

C. Description of monument for corner and accessories established to perpetuate locating the position of the corner:

- B-7: 1/4 Corner common to Sections 18 & 19
Set 5/8" x 36" re-rod with brass cap stamped "Midland Co. Remon. Cor. PS 9433" in Monument Box.
S 30°W, 23.97' - Nail & Disc, 24" Oak (1)
S 35°E, 40.21' - Nail & Disc, 8" Hickory (3)
SOUTH, 61.40' - Nail & Disc, Power Pole
NORTH, 1.0' - @ Road
S 76°W, 124.3' - West Power Pole - Nail & Disk.

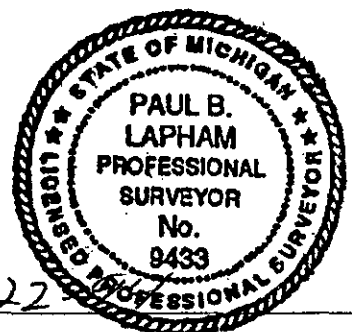

Signed by Paul B. Lapham Date 9-22
Surveyor's Michigan License No. 9433