

APPROVED LAND CORNER
P.A. 345 OF 1990
MIDLAND COUNTY

LAND CORNER RECORDATION CERTIFICATE
Filing Requirement of Act 74, Mich. P.A. 1970

305

11/12/96

For corners in

| | | |
|------------------------------------|--|---------------|
| <u>MIDLAND</u> (County) | Located In: | Corner Code # |
| 1. Public Land Survey | T <u>16N</u> R <u>2W</u> | <u>E-2</u> |
| | T <u> </u> R <u> </u> | <u> </u> |
| | T <u> </u> R <u> </u> | <u> </u> |
| | T <u> </u> R <u> </u> | <u> </u> |
| 2. Property Controlling in Section | S <u> </u> T <u> </u> R <u> </u> | <u> </u> |
| | S <u> </u> T <u> </u> R <u> </u> | <u> </u> |
| 3. Miscellaneous Property in Sec. | S <u> </u> T <u> </u> R <u> </u> | <u> </u> |
| | S <u> </u> T <u> </u> R <u> </u> | <u> </u> |

STATE OF MICHIGAN
MIDLAND COUNTY
~~RECORDED~~
REMONUMENTATION & FILED.
20 DEC 96 2:05 P.M.
BEVERLY J THAYER
Register of Deeds State of Michigan File Number

4. Lot No. _____, Recorded Plat _____
5. Private Claims _____

| | | | | | | | | | | | | |
|----|----|---|----|----|---|---|----|---|----|---|---|----|
| A | B | C | D | E | F | G | H | I | J | K | L | M |
| 1 | | | | | | | | | | | | |
| 2 | 6 | | 5 | 4 | | | 3 | | 2 | | | 1 |
| 3 | | | | | | | | | | | | |
| 4 | 7 | | 8 | 9 | | | 10 | | 11 | | | 12 |
| 5 | | | | | | | | | | | | |
| 6 | 18 | | 17 | 16 | | | 15 | | 14 | | | 13 |
| 7 | | | | | | | | | | | | |
| 8 | 19 | | 20 | 21 | | | 22 | | 23 | | | 24 |
| 9 | | | | | | | | | | | | |
| 10 | 30 | | 29 | 28 | | | 27 | | 26 | | | 25 |
| 11 | | | | | | | | | | | | |
| 12 | 31 | | 32 | 33 | | | 34 | | 35 | | | 36 |
| 13 | | | | | | | | | | | | |

I, MARK R. ROBISON, in a field survey on OCTOBER, 1996 do hereby state that under requirements of P.A. 74, Michigan P.A. of 1970, the corner points mentioned in lines 1 and 2 above were in conformance with regulations and rules therefore as required in the current manual of survey instructions of the United States Department of the Interior, Bureau of Land Management or by a decree of a Court of Law and /or that the corner points mentioned in lines 3, 4 and 5 above were in conformance with the rules of the Michigan Board of Land Surveyors or by a Decree of a Court of Law, established, re-established, monumented, recovered, found as expressed below:

NOTE: Not more than 2 corners, all in the same town and range, may be recorded on this certificate.

A. Description of original monument and accessories and/or subsequent restoration:

- 1832 WRIGHT
WIT.-SET 1/4 SEC. POST.
W. ASH 8" S55°E 18
ELM 12" N55°W 18
- 11-13-01 GIBBS C.S.R.
WIT.-SET PIECE OF SLEIGH SHOE.
PINE STUMP S33°E 62
- 10-14-10 GIBBS C.S.R.
WIT.-R.R. STRAP IRON OLD COR.
SET IN SURVEY OF SEC. 4

B. Description of corner evidence found and/or method applied in restoring or reestablishing corner:


FOUND 1/2"x18" RE-ROD. MEAS. 2752.04 TO E-1 (GIBBS 2741.64). MEAS. SOUTH 2636.89 TO E-3 (GIBBS 2637.36). OLD FENCE (LAYING DOWN) TO WEST. SHALLOW DRAIN DITCH TO EAST (FENCE HAS BEEN REMOVED AND ROLLED UP). SEARCHED DILIGENTLY BUT COULD NOT FIND SLEIGH SHOE OR STRAP IRON. ACCEPTED 1/2"x18" RE-ROD AS POSITION OF CORNER.

Corner, E-2 was approved for remonumentation at a Peer Review Committee Meeting on 11-12 1996.

C. Description of monument for corner and accessories established to perpetuate locating the position of the corner:

SET 3/4"x18" PIPE WITH STANDARD MON. CAP AT CORNER.
ACCEPTED AS BEST AVAILABLE EVIDENCE OF THE ACCEPTED POSITION OF THE CORNER.

- WITNESSES:
- N84°W, 52.66' - NAIL & TAG IN POWER POLE.
 - EAST, 39.36' - NAIL & TAG IN 21" ASH.
 - N33°E, 128.71' - NAIL & TAG IN 13" ASH.
 - N58°W, 97.94' - NAIL & TAG IN TWIN 19" ASH.

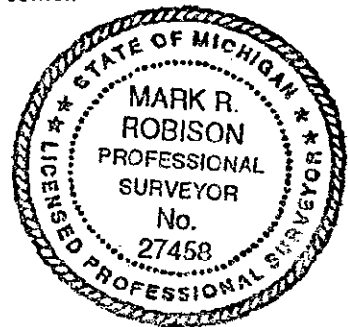

Signed by MARK R. ROBISON
Surveyor's Michigan License No. 27458

Date 12-19-96