

APPROVED LAND CORNER  
P.A. 345 OF 1990  
MIDLAND COUNTY

4/12/96 J&J

LAND CORNER RECORDATION CERTIFICATE  
Filing Requirement of Act 74, Mich. P.A. 1970

306

For corners in

MIDLAND (County)	Located In:	Corner Code #
1. Public Land Survey	T 16N R 2W	E-3
	T R	
	T R	
	T R	
2. Property Controlling in Section	S T R	
	S T R	
3. Miscellaneous Property in Sec.	S T R	
	S T R	

STATE OF MICHIGAN  
MIDLAND COUNTY  
REMONUMENTATION & FILED

20 DEC 96 2:06 P.M.

BEVERLY J THAYER  
REGISTER OF DEEDS

Register of Deeds Stamp & File Number

4. Lot No. \_\_\_\_\_, Recorded Plat \_\_\_\_\_  
5. Private Claims \_\_\_\_\_

I, MARK R. ROBISON, in a field survey on OCTOBER, 1996 do hereby state that under requirements of P.A. 74, Michigan P.A. of 1970, the corner points mentioned in lines 1 and 2 above were in conformance with regulations and rules therefore as required in the current manual of survey instructions of the United States Department of the Interior, Bureau of Land Management or by a decree of a Court of Law and /or that the corner points mentioned in lines 3, 4 and 5 above were in conformance with the rules of the Michigan Board of Land Surveyors or by a Decree of a Court of Law; established, re-established, monumented, recovered, found as expressed below:

NOTE: Not more than 2 corners, all in the same town and range, may be recorded on this certificate.

	A	B	C	D	E	F	G	H	I	J	K	L	M
1													
2	6		5		4		3		2		1		
3													
4	7		8		9		10		11		12		
5													
6	18		17		16		15		14		13		
7													
8	19		20		21		22		23		24		
9													
10	30		29		28		27		26		25		
11													
12	31		32		33		34		35		36		
13													

A. Description of original monument and accessories and/or subsequent restoration:

1832 WRIGHT  
WIT.-SET POST  
CEDAR 10" N47°W 24 LKS.  
BIRCH 12" S58°E 23 LKS.

10-14-10 GIBBS, C.S.R.  
WIT.-POST & IRON-OLD CORNER SET IN  
SURVEY OF SEC. 8.

6-21-01 GIBBS, C.S.R.  
WIT.-POST AND GAS PIPE.

11-13-01 GIBBS, C.S.R.  
WIT.-POST AND IRON OLD CORNER

11-11-09 GIBBS, C.S.R.  
WIT-OLD CORNER

B. Description of corner evidence found and/or method applied in restoring or reestablishing corner:


CORNER WAS NOT IN. OLD RESIDENT SAID THAT ROAD CONSTRUCTION HAD REMOVED CORNER AND IT WAS NOT REPLACED. SET AT DOUBLE PROPORTIONATE MEASURE BETWEEN 1/4 CORNERS N, S, E. & W.

Corner, E-3 was approved for remonumentation at a Peer Review Committee Meeting on 11-12 1996.

C. Description of monument for corner and accessories established to perpetuate locating the position of the corner:

SET 3/4"x18" PIPE WITH STANDARD MON. CAP AT CORNER, ACCEPTED AS FAITHFUL RE-ESTABLISHMENT OF C.S.R. CORNER BY DOUBLE PROPORTIONATE MEASURE.

WITNESSES:  
N14°E, 120.24' - NAIL & TAG IN 37" WILLOW.  
N56°E, 79.68' - NAIL & TAG IN 34" ASH.  
S55°E, 38.44' - NAIL & TAG IN POWER POLE STUB.  
S18°W, 143.78' - NAIL & TAG IN POWER POLE.

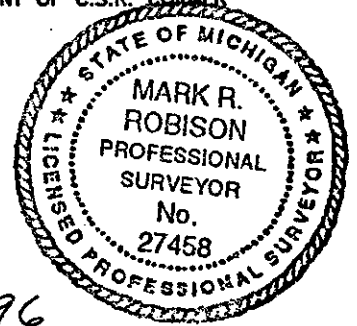

Signed by Mark R. Robison  
Surveyor's Michigan License No. 27458

Date 12-19-96