

APPROVED LAND CORNER
P.A. 345 OF 1990
MIDLAND COUNTY

LAND CORNER RECORDATION CERTIFICATE
Filing Requirement of Act 74, Mich. P.A. 1970
Midland County Remonumentation

427

STATE OF MICHIGAN
MIDLAND COUNTY
RECORDED

12/7/1999 2:59:31 PM

SCOTT I. HAINES
REGISTER OF DEEDS

9/13/99 JSB

For Corners in
Midland

(County) Located In: Corner Code#:

- 1. Public Land Survey T. 16 R. 2W Corner Code# H-1
- T. _____ R. _____
- T. _____ R. _____
- 2. Public Controlling S. _____ T. _____ R. _____
- in Section S. _____ T. _____ R. _____
- 3. Miscellaneous S. _____ T. _____ R. _____
- Property in Section S. _____ T. _____ R. _____
- 4. Lot No. _____, Recorded Plat _____
- 5. Private Claims _____

Register of Deeds Stamp & File Number

I, Mark R. Robison, in a field survey on 6-8-1999, do hereby certify that under requirements of P.A. 74, Michigan P.A. of 1970, the corner points mentioned in lines 1 and 2 above were in conformance with regulations and rules therefore as required in the current manual of survey instructions of the United States Department of the Interior, Bureau of Land Management or by a decree of a Court of Law and/or that the corner points mentioned in lines 3, 4 and 5 above were in conformance with the rules of the Michigan Board of Land Surveyors or by a Decree of a Court of Law, established, re-established, monumented, re-monumented, recovered, found as expressed below.

	A	B	C	D	E	F	G	H	I	J	K	L	M
2	6	5	4	3	2	1							
3													
4	7	8	9	10	11	12							
5													
6	18	17	16	15	14	13							
7													
8	19	20	21	22	23	24							
9													
10	30	29	28	27	26	25							
11													
12	31	32	33	34	35	36							
13													

NOTE: Not more than 2 corners, all in the same town and range, may be recorded on this certificate.

A. Description of original monument and accessories and/or subsequent restoration:

Not set in GLO Survey
 8-21-17 Gibbs, CSR 1974 Lapham, LCRC,
 312Set post at Avg. distance on true line. Set 1/2" bar
 Meas. 40.24 both ways N 03° E 13.85 40" Cottonwood
 NOTE: G-1 & I-1 previously remonumented in N 05° W 25.02 Cor. F. Post
 Midland County Remon Program N 87° W 163.37 30" Cottonwood

SURVEY & REMONUMENTATION

FEB 09 2000

SECTION

1997 Robison
Set 1/2 iron on line at S.P.M
between G-1 & I-1 on Std. Line
replaced with 3/4" x 18" Gas Pipe

B. Description of corner evidence found and/or method applied in restoring or re-establishing corner:

Found 3/4" x 18" Gas Pipe with Midland County Remon Cap. Measured 2650.82 both ways to G-1 & I-1. Corner falls on line between Std. Section Corners. G-1 & I-1 are Remonumented Corners.


Corner H-1, T16N, R2W was approved for remonumentation at a Peer Review Committee Meeting on 9/12/99

C. Description of monument for corner and accessories established to perpetuate locating the position of the corner:

Found 3/4" x 18" Gas Pipe with Brass Cap stamped "Midland County Remon. Cor. P.S. 27458". Set Mon. Box. Accepted as best method of establishment of the position of the corner.

Witnesses:
N28°E 45.74', nail & tag, 12" J. Pine
N79°W 164.60', nail & tag 40" Bass Wood (OBT)
N60°W 74.84', nail & tag, Cor. F. Post
S27°W 41.60', nail & tag, in Fence Post

Signed by Mark R. Robison
Surveyor's Michigan License No. 27458

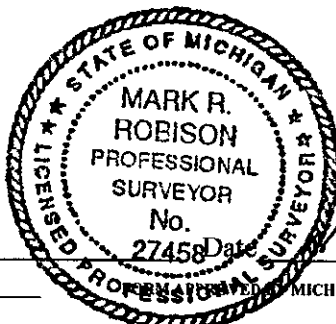

MICHIGAN STATE BOARD OF LAND SURVEYORS, JAN. 28, 1971

REVISED MAY 14, 1975
REVISED JAN., 1983