

JAN 21 1999

APPROVED LAWYER
P.A. 845 OF 1990
MIDLAND COUNTY

MIDLAND County Remonumentation

SECTION

LAND CORNER RECORDATION CERTIFICATE
Filing Requirement of Act 74, Mich. P.A. 1970

379

For corners in 9/09/98

MIDLAND (County)	Located in:	Corner Code #
1. Public Land Survey	T16N R02W	J-5
	T R	
	T R	
	T R	
2. Property Controlling in Section	S T R	
	S T R	
3. Miscellaneous Property in Sec.	S T R	
	S T R	

STATE OF MICHIGAN
MIDLAND COUNTY
REMONUMENTATION & FILED
12/16/1998 12:11:56 PM
BEVERLY J. THAYER
REGISTER OF DEEDS

Register of Deeds Stamp & File Number

4. Lot No. _____, Recorded Plat _____
5. Private Claims _____

I, Mark R Robison, in a field survey on September, 1998 do hereby state that under requirements of P.A. 74, Michigan P.A. of 1970, the corner points mention in lines 1 and 2 above were in conformance with regulations and rules therefore as required in the current manual of survey instructions of the United States Department of the Interior, Bureau of Land Management or by a decree of a Court of Law and/or that the corner points mentioned in lines 3, 4 and 5 above were in conformance with the rules of the Michigan Board of Land Surveyors or by a Decree of a Court of Law; established, re-established, monumented, recovered, found as expressed below:

	A	B	C	D	E	F	G	H	I	J	K	L	M
1													
2	6		5		4		3		2		1		
3													
4	7		8		9		10		11		12		
5													
6	18		17		16		15		14		13		
7													
8	19		20		21		22		23		24		
9													
10	30		29		28		27		26		25		
11													
12	31		32		33		34		35		36		
13													

NOTE: Not more than 2 corners, all in the same town and range, may be recorded on this certificate

A. Description of original monument and accessories and/or subsequent restoration:

- J-5: 1830 Wright 1/4 Sec Post
Wit-1) Hemlock 6" S2W 19 lks
2) Maple 12" N2E 29 lks
- 6-14-73 Lapham Survey of Section 11--
Calc Sheet & Unrec Survey--Found Corner
Meas 2652.33 West & 2652.21 East
- 2-14-74 Lapham LCRC#282 Fd 1/2" Bar
Wit-1) N25E 83.8 SW Cor 1-St Hse
2) S05E 31.5 End Fence Post
3) S50W 49.92 P.P.
- 4-10-74 Lapham (132) 1-632 Ref LCRC#282
- 5-23-74 Urbaniak(132)1-642 Ref LCRC#282


B. Description of corner evidence found and/or method applied in restoring or reestablishing corner:

J-5: Found 1/2" x 24" rerod. Excavated and found no other evidence. Found 1974 witnesses. Measured East 2652.44 (Previously measured 2652.21) feet to Section Corner.
Corner, J-5, was approved for remonumentation at a Peer Review Committee Meeting on 9/09/98

C. Description of monument for corner and accessories established to perpetuate locating the position of the corner:

J-5: Set 3/4" x 18" Gas Pipe with Brass Cap stamped "Midland Co. Remon. Cor. P.S.27458" in Monument Box. Accepted as best available evidence of accepted position of corner.

- Witnesses:
- N10E 83.80' SW Corner One-Story House (OBT)
 - S05E 31.50', nail & tag, End Fence Post (OBT)
 - S50W 49.92', nail & tag, P.P. (OBT)
 - N09W 31.80' Center of Telephone Riser

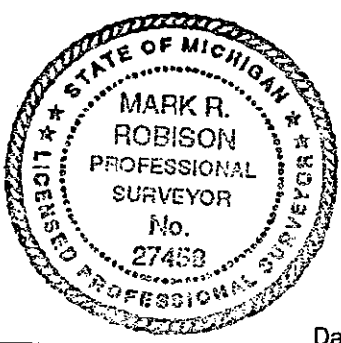

Signed by Mark R. Robison
Surveyor's Michigan License No. 27458

Date 12-09-98