

**SURVEY &
REMONUMENTATION**

**APPROVED LAND CORNER
P.A. 345 OF 1990
MIDLAND COUNTY**

APR 28 1995

COMMISSION

**LAND CORNER RECORDATION CERTIFICATE
Filing Requirement of Act 74, Mich. P.A. 1970**

95

STATE OF MICHIGAN
MIDLAND COUNTY
FILED & REMON

28 SEP 94 3:31 P.M.

BEVERLY J THAYER
REGISTER OF DEEDS

Register of Deeds Stamp & File Number

For corners in

<u>MIDLAND</u> (County)	Located In:	Corner Code #
1. Public Land Survey	T <u>16N</u> R <u>2W</u>	<u>L-3</u>
	T _____ R _____	_____
	T _____ R _____	_____
	T _____ R _____	_____
2. Property Controlling in Section	S _____ T _____ R _____	_____
	S _____ T _____ R _____	_____
3. Miscellaneous Property in Sec.	S _____ T _____ R _____	_____
	S _____ T _____ R _____	_____

4. Lot No. _____, Recorded Plat _____
5. Private Claims _____

	A	B	C	D	E	F	G	H	I	J	K	L	M
2	6		5		4		3		2		1		
3													
4	7		8		9		10		11		12		
5													
6	18		17		16		15		14		13		
7													
8	19		20		21		22		23		24		
9													
10	30		29		28		27		26		25		
11													
12	31		32		33		34		35		36		
13													

I, PAUL B. LAPHAM, in a field survey on JULY, 19 94, do hereby certify that under requirements of P.A. 74, Michigan P.A. of 1970, the corner points mentioned in lines 1 and 2 above were in conformance with regulations and rules therefore as required in the current manual of survey instructions of the United States Department of the Interior, Bureau of Land Management or by a decree of a Court of Law and/or that the corner points mentioned in lines 3, 4 and 5 above were in conformance with the rules of the Michigan Board of Land Surveyors or by a Decree of a Court of Law; established, re-established, monumented, re-monumented, recovered, found as expressed below:

NOTE: Not more than 4 corners, all in the same town and range, may be recorded on this certificate.

A. Description of original monument and accessories and/or subsequent restoration:

L-3: 1/4 Corner common to Sections 1 & 12
1832 - Jack Wright, Hemlock 12" N 37°W 35 lks, Hemlock 12" S 37°E 41 lks
No. C.S.R.
12/26/73 - John Sedgman, Set Spike (132) 1-527
(1) S 50°W, 66.05' - 3" Willow Tree (2) S 10°E, 39.68' - 10" Apple Tree (3) S 45°E, 92.47' - 7" Pine Tree
02/14/74 - Paul Lapham, L.C.R.C. 280
Witnessed as above
03/24/80 - Harvey Gilbert, 1/2" Rod (132) 4-30-80
(2) S 07°E, 39.72' - 12" Apple (1) S 52°W, 65.90' - 10" Willow

B. Description of corner evidence found and/or method applied in restoring or reestablishing corner:


L-3: 1/4 Corner common to Sections 1 & 12
Found 1" x 18" Pipe Approx. 1' deep. Excavated 3 feet, Found no other evidence
Found Witness No. 1 and No. 2

Accepted as best available evidence of the position of the original corner & replaced with Standard Monument.

Corner, L-3 was approved for remonumentation at a Peer Review Committee Meeting on SEP 31, 1994.

C. Description of monument for corner and accessories established to perpetuate locating the position of the corner:

L-3: 1/4 Corner common to Sections 1 & 12
Set 5/8" x 18" re-rod with brass cap stamped "Midland Co. Remon. Cor. PS 9433" in Monument Box.
N30°E 39.85' - Corner Fence Post - Nail & Disc.
S45°E 60.10' - 12" Pine - Nail & Disc.
S10°E 39.75' - 10" Apple - Nail & Disc. (2)
S45°W 65.90' - 26" Willow - Nail & Disc. (1)

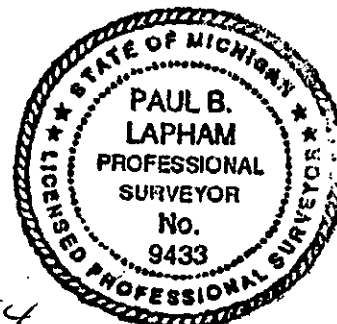

Signed by Paul B. Lapham Date 9-22-94
Surveyor's Michigan License No. 9433