

**SURVEY &
REMONUMENTATION**

JAN 21 1999

APPROVED LAND CORNER
P.A. 345 OF 1990
MIDLAND COUNTY

MIDLAND County Remonumentation

LAND CORNER RECORDATION CERTIFICATE
Filing Requirement of Act 74, Mich. P.A. 1970

SECTION

9/09/98

For corners in

<u> </u> MIDLAND <u> </u>	Located in:	Corner Code #
(County)		
1. Public Land Survey	T16N R02W	L-5
	T <u> </u> R <u> </u>	<u> </u>
	T <u> </u> R <u> </u>	<u> </u>
	T <u> </u> R <u> </u>	<u> </u>
2. Property Controlling in Section	S <u> </u> T <u> </u> R <u> </u>	<u> </u>
	S <u> </u> T <u> </u> R <u> </u>	<u> </u>
3. Miscellaneous Property in Sec.	S <u> </u> T <u> </u> R <u> </u>	<u> </u>
	S <u> </u> T <u> </u> R <u> </u>	<u> </u>

417

STATE OF MICHIGAN
MIDLAND COUNTY
REMONUMENTATION & FILED

12/30/1998 1:33:41 PM

Register of Deeds Stamp & File Number
BEVERLY J. THAYER
REGISTER OF DEEDS

4. Lot No. , Recorded Plat
5. Private Claims

I, Mark R Robison, in a field survey on June, 1998 do hereby state that under requirements of P.A. 74, Michigan P.A. of 1970, the corner points mention in lines 1 and 2 above were in conformance with regulations and rules therefore as required in the current manual of survey instructions of the United States Department of the Interior, Bureau of Land Management or by a decree of a Court of Law and/or that the corner points mentioned in lines 3, 4 and 5 above were in conformance with the rules of the Michigan Board of Land Surveyors or by a Decree of a Court of Law; established, re-established, monumented, recovered, found as expressed below:

NOTE: Not more than 2 corners, all in the same town and range, may be recorded on this certificate

1	A	B	C	D	E	F	G	H	I	J	K	L	M
2		6		5		4		3		2		1	
3													
4		7		8		9		10		11		12	
5													
6		18		17		16		15		14		13	
7													
8		19		20		21		22		23		24	
9													
10		30		29		28		27		26		25	
11													
12		31		32		33		34		35		36	
13													

A. Description of original monument and accessories and/or subsequent restoration:

L-5: 1830 Wright 1/4 Sec Post
Wit-1)B. Ash 14" N15W 21 lks
2)Elm 18" S15E 21 lks

8-5-92 Robison (132) 4-908 Fd 1/2" C.I.
Wit-same as 6-22-79

5-11-64 Whittier - Unrec Survey Sec 12
K-5 to L-5 is 2628.02
L-5 to M-5 is 2641.40

6-22-79 Lapham Unrec Survey & Calc Dwg
Set 1/2" capped rerod
Wit-1)South 33.60 Fence Cor
2)S60E 96.20 6" Bass Wood
3)S10W 33.90 Fence Post

9-5-79 Lapham LCRC#507
Set 1/2" Capped rerod - Prorated C.S.R. (Whittier)
Wit-same as 6-22-79

B. Description of corner evidence found and/or method applied in restoring or reestablishing corner:


L-5: Found 1/2" x 18" Iron. Corner falls 4 feet East of Fence Post to South. Found two 1979 witnesses. Measured West 2627.15 (Previously 2628.02) feet to K-5. Measured East 2641.72 (Previously 2641.40) feet to M-5.

Corner, L-5. was approved for remonumentation at a Peer Review Committee Meeting on 9/09/98

C. Description of monument for corner and accessories established to perpetuate locating the position of the corner:
L-5: Set 3/4" x 18" Gas Pipe with Brass Cap stamped "Midland Co. Remon. Cor. P.S.27458" in Monument Box. Accepted as best available evidence of accepted position of corner.

Witnesses:
S07W 33.70', nail & tag, Fence Post (OBT)
S60E 95.6', nail & tag, 12" Bass Wood Clump (OBT)
S40E 36.3' W. End 15" C.M.P.
North 136.58', nail & tag, P.P.

Signed by Mark R. Robison
Surveyor's Michigan License No. 27458

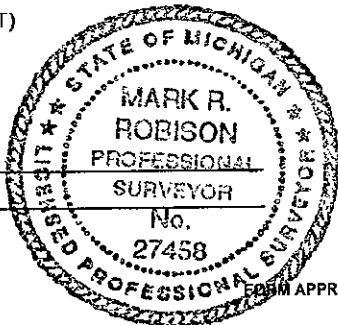

Date 12-21-98