

**SURVEY &
REMONUMENTATION**

APPROVED LAND CORNER
P.A. 345 OF 1990
MIDLAND COUNTY

APR 28 1995

100

92

**COMMISSION
LAND CORNER RECORDATION CERTIFICATE
Filing Requirement of Act 74, Mich. P.A. 1970**

STATE OF MICHIGAN
MIDLAND COUNTY
FILED & REMON

28 SEP 94 3:30 P.M.

BEVERLY J THAYER
REGISTER OF DEEDS

Register of Deeds Stamp & File Number

For corners in

<u>MIDLAND</u> (County)	Located in:	Corner Code #
1. Public Land Survey	T <u>16N</u> R <u>2W</u>	<u>M-3</u>
	T _____ R _____	_____
	T _____ R _____	_____
	T _____ R _____	_____
2. Property Controlling in Section	S _____ T _____ R _____	_____
	S _____ T _____ R _____	_____
3. Miscellaneous Property in Sec.	S _____ T _____ R _____	_____
	S _____ T _____ R _____	_____

4. Lot No. _____, Recorded Plat _____
5. Private Claims _____

	A	B	C	D	E	F	G	H	I	J	K	L	M
2	6	5	4	3	2	1							
3													
4	7	8	9	10	11	12							
5													
6	18	17	16	15	14	13							
7													
8	19	20	21	22	23	24							
9													
10	30	29	28	27	26	25							
11													
12	31	32	33	34	35	36							
13													

PAUL B. LAPHAM, in a field survey on JULY, 19 94,
do hereby certify that under requirements of P.A. 74, Michigan P.A. of 1970, the corner points mentioned
in lines 1 and 2 above were in conformance with regulations and rules therefore as required in the
current manual of survey instructions of the United States Department of the Interior, Bureau of Land
Management or by a decree of a Court of Law and/or that the corner points mentioned in lines 3, 4 and 5
above were in conformance with the rules of the Michigan Board of Land Surveyors or by a Decree of a
Court of Law; established, re-established, monumented, re-monumented, recovered, found as
expressed below:

**NOTE: Not more than 4 corners, all in the same town and range, may be recorded
on this certificate.**

A. Description of original monument and accessories and/or subsequent restoration:

- M-3: Section Corner on East Township line common to Sections 1 & 12
1832 - Jack Wright, Birch 7" S 87°W 18 lks, Elm 16" N 27°W 20 lks
No C.S.R.
- 03/24/80 - Harvey Gilbert, 5/8" Rod in Mon. Box (132) 3-48
- 04/20/83 - Paul Lapham, Monument Box, L.C.R.C. 580 4/25/83
 - (1) S 80°E, 60.95' - Stud Pole
 - (2) S 40°E, 97.30' - U.S.G.S. Bench Mark
 - (3) N 70°E, 88.5' - Power Pole
 - (4) S 50°W, 72.35' - Stud Pole

3. Description of corner evidence found and/or method applied in restoring or reestablishing corner:


- M-3: Section Corner on East Township line common to Sections 1 & 12
Found 1/2" x 18" Capped Iron in Mon. Box. Excavated to 3 foot depth. Did not find further evidence.
Found Recorded Witnesses 1, 2 & 3.

Accepted as best available evidence of the position of the original corner & replaced with Standard Monument.

Corner, M-3 was approved for remonumentation at a Peer Review Committee Meeting on SEPT. 21, 1994.

B. Description of monument for corner and accessories established to perpetuate locating the position of the corner:

- M-3: Section Corner on East Township line common to Sections 1 & 12
Set 5/8" x 18" re-rod with brass cap stamped "Midland Co. Remon. Cor. PS 9433" in Monument Box.
 - S 80°E, 60.95' - Stud Pole (1)
 - S 40°E, 97.30' - U.S.G.S. Bench Mark (2)
 - N 70°E, 88.5' - Power Pole (3)
 - N 45°E, 70.70' - Capped Iron

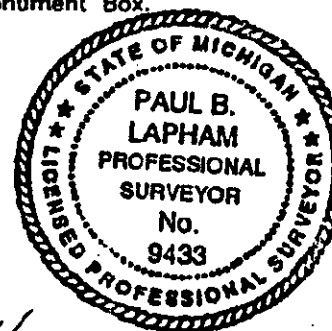

Signed by Paul B. Lapham

Date 9-27-94

Surveyor's Michigan License No. 9433