

RATIFIED BY PEER GROUP
PA 345 OF 1990
MONROE COUNTY, MICHIGAN

date: 8/29/1995
County Rep.: [Signature]

LAND CORNER RECORDATION CERTIFICATE
Filing Requirement of Act 74, Mich. P.A. 1970

RECEIVED FOR RECORD
93 DEC 29 AM 9:01

For corners in
Monroe (58)
(County)

Located In: _____ Corner Code # _____

- | | | |
|---------------------------------------|-------------------------|-------------|
| 1. Public Land Survey
London Twp. | T _____ R _____ | |
| | T <u>5S</u> R <u>7E</u> | <u>G-12</u> |
| | T _____ R _____ | |
| | T _____ R _____ | |
| 2. Property Controlling
in Section | S _____ T _____ R _____ | |
| | S _____ T _____ R _____ | |
| 3. Miscellaneous
Property in Sec. | S _____ T _____ R _____ | |
| | S _____ T _____ R _____ | |

**SURVEY &
REMONUMENTATION**

APR 04 1996

COMMISSION

Register of Deeds Stamp & File Number

4. Lot No. _____, Recorded Plat _____
5. Private Claims _____
1995 REMONUMENTATION PROGRAM
Peer Group approved 8/29/1995

	A	B	C	D	E	F	G	H	I	J	K	L	M
2	6	5	4	3	2	1							
3													
4	7	8	9	10	11	12							
5													
6	18	17	16	15	14	13							
7													
8	19	20	21	22	23	24							
9													
10	30	29	28	27	26	25							
11													
12	31	32	33	34	35	36							
13													

I, G.B. WARNKE, JR., in a field survey on 10/26/1995, 19_____, do hereby certify that under requirements of P.A. 74, Michigan P.A. of 1970, the corner points mentioned in lines 1 and 2 above were in conformance with regulations and rules therefore as required in the current manual of survey instructions of the United States Department of the Interior, Bureau of Land Management or by a decree of a Court of Law and/or that the corner points mentioned in lines 3, 4 and 5 above were in conformance with the rules of the Michigan Board of Land Surveyors or by a Decree of a Court of Law; established, re-established, monumented, re-monumented, recovered, found as expressed below:

NOTE: Not more than 4 corners, all in the same town and range, may be recorded on this certificate.

A. Description of original monument and accessories and/or subsequent restoration:
1/4 Corner common to Sections 33 & 34 / 900 - 1000 feet North of Tuttlehill Road @ NE corner of 2.068 acre parcel per Kenneth Suydam survey recorded in Liber 630, Page 677.
1819, GLO Surveyor, J. Fletcher, set wood post - witnesses: W. Oak 12 N56E 43 & Elm 16 N30E 22.
1971-1972, Kenneth Suydam surveys, Liber 630, Page 677-678 & Liber 636, Page 290, & LCRC, Liber 1, Page 91, used corner and LCRC notes found pointed stone and set 3/4" x 48" iron pipe on east side of stone.
1973, A.J. Marino survey states Fd. I. & Stone. 1973, M.R. Fleck survey recorded in Liber 644, Page 965, states F.IP. 1993, G.B. Warnke recorded LCRC, Liber 3, Page 307, found stone and found 3/4" iron pipe S45°E 0.20' from stone.


B. Description of corner evidence found and/or method applied in restoring or reestablishing corner:

8/95 Found stone and found 3/4" iron pipe S45°E 0.20' from stone. 8/29/95 - corner was Peer Group approved.
10/26/95 Set 1" X 36" iron pipe with brass remonumentation cap to replace found stone

C. Description of monument for corner and accessories established to perpetuate locating the position of the corner:

Set 1" X 36" iron pipe with brass remonumentation cap to replace found stone and is accepted as the best available evidence of the position of the original corner and witnesses:
South 45° East 0.20 feet to 3/4 inch iron pipe
South 85° East 19.99 feet to found nail/shiner in west face of 36" Oak
South 18.02 feet to found nail/shiner in northwest face 12" Cherry
North 5° East 14.91 feet to found nail/shiner in west face 18" Elm
North 45° West 28.00 feet to found nail/shiner in north-northeast face of 30" Cottonwood
North 19 feet +/- to centerline of small drain

Signed by [Signature] Date 10/26/1995
Surveyor's Michigan License No 19474

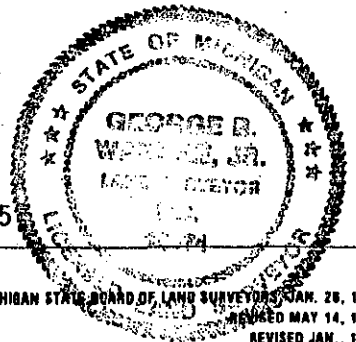

FORM APPROVED BY MICHIGAN STATE BOARD OF LAND SURVEYORS, JAN. 26, 1977
REVISED MAY 14, 1975
REVISED JAN., 1983

① G-12 (5/7) LONDON TWP.