

NOV 10 1997

97 SEP 24 PM 3: 33

COMMISSION

**LAND CORNER RECORDATION CERTIFICATE
Filing Requirement of Act 74, Mich. P.A., 1970**

Heri Allen
REGISTER OF DEEDS
MONROE COUNTY, MICH

For corners in

<u>Monroe</u> (County)	Located In:	Corner Code #
	London Twp.	
1. Public Land Survey	T <u>5S</u> R <u>7E</u>	<u>H-4</u>
	T _____ R _____	_____
	T _____ R _____	_____
	T _____ R _____	_____
2. Property Controlling in Section	S _____ T _____ R _____	_____
	S _____ T _____ R _____	_____
3. Miscellaneous Property in Sec.	S _____ T _____ R _____	_____
	S _____ T _____ R _____	_____

Register of Deeds Stamp & File Number

4. Lot No. _____, Recorded Plat _____

5. Private Claims _____

1	A	B	C	D	E	F	G	H	I	J	K	L	M
2	6		5		4		3		2		1		
3													
4	7		8		9		10		11		12		
5													
6	18		17		16		15		14		13		
7													
8	19		20		21		22		23		24		
9													
10	30		29		28		27		26		25		
11													
12	31		32		33		34		35		36		
13													

I, George B. Warnke, Jr., in a field survey on April 25, 1997 do hereby state that under requirements of P.A. 74, Michigan P.A. of 1970, the corner points mentioned in lines 1 and 2 above were in conformance with regulations and rules therefore as required in the current manual of survey instructions of the United States Department of the Interior, Bureau of Land Management or by decree of a Court of Law and / or that the corner points mentioned in lines 3, 4 and 5 above were in conformance with the rules of the Michigan Board of Land Surveyors or by a Decree of a Court of Law; established, re-established, monumented, recovered, found as expressed below:

NOTE: Not more than 2 corners, all in the same town and range, may be recorded on this certificate.

1997 G.B. Warnke Corner
Center of Section 10 / not in road (580' off Tuttlehill Road)

A. Description of original monument and accessories and/or subsequent restoration:

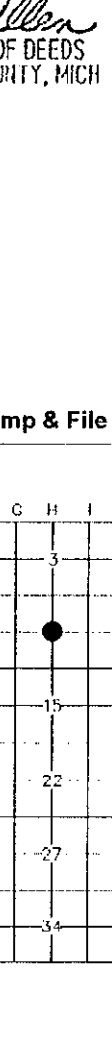
- H-4, T5S, R7E,**
 1969, A.J. Marino field notes and survey note found 1/4" iron rod with stake - no witnesses
 1977, A.J. Marino field notes and survey note found iron rod, iron rod 0.5' W.
 1990, G.B. Warnke survey (#90-065) notes found 1/4" iron rod - witness: West 0.47' found 5/8" iron rod
 1997, G.B. Warnke survey (#97-0046) notes set 1" x 36" pipe with brass cap over a 1/4" rod - witnesses:
 N 30° W 4.95' double head nail SW face 8" maple
 N 80° E 11.42' double head nail N'ly face multi trunk maple
 S 30° E 6.45' double head nail SW face 6" maple
 S 85° W 3.12' set nail/shiner N face 6" maple

B. Description of corner evidence found and/or method applied in restoring or re-establishing corner:

- H-4, T5S, R7E**
 April, 1997, G.B. Warnke field crew found 1/4" iron rod in accordance with A.J. Marino surveys of 1969 and 1977.
 8/26/97 corner was ratified by peer group PA 345 of 1990, Monroe County, Michigan.

C. Description of monument for corner and accessories established to perpetuate locating the position of the corner:

- H-4, T5S, R7E**
 1997, set 1" x 36" pipe with brass remonumentation cap over a 1/4" rod. This position was not established by original government surveyors. This monument is accepted as the best available evidence of the position of the corner.
 witnesses:
 N 30° W 4.95' double head nail SW face 8" maple
 N 80° E 11.42' double head nail N'ly face multi trunk maple
 S 30° E 6.45' double head nail SW face 6" maple
 S 85° W 3.12' set nail/shiner N face 6" maple

Signed by 



8-27-97

Surveyor's Michigan License No. 19474

APPROVED BY MICHIGAN STATE BOARD OF LAND SURVEYORS, JAN. 28, 1971
 REVISED MAY 14, 1975
 REVISED JAN., 1983
 REVISED OCT., 1994