

RATIFIED BY PEER GROUP  
PA 345 OF 1990  
MONROE COUNTY, MICHIGAN  
date: 9/26/1995  
County Rep.: [Signature]

LAND CORNER RECORDATION CERTIFICATE  
Filing Requirement of Act 74, Mich. P.A. 1970

RECEIVED FOR RECORD  
95 DEC 28 AM 9:01  
REGISTER OF DEEDS  
MONROE COUNTY, MICHIGAN

For corners in  
Monroe (58)  
(County)

Located In:

SURVEY &  
REMONUMENTATION  
Corner Code: 77

- 1. Public Land Survey  
London Twp. T 5S R 7E
- 2. Property Controlling  
in Section S      T      R
- 3. Miscellaneous  
Property in Sec. S      T      R

H-13 APR 04 1996

COMMISSION

Register of Deeds Stamp & File Number

- 4. Lot No.     , Recorded Plat
- 5. Private Claims

	A	B	C	D	E	F	G	H	I	J	K	L	A
2	6		5		4		3		2		1		
3													
4	7		8		9		10		11		12		
5													
6	18		17		16		15		14		13		
7													
8	19		20		21		22		23		24		
9													
10	30		29		28		27		26		25		
11													
12	31		32		33		34		35		36		
13													

1995 REMONUMENTATION PROGRAM  
Peer Group approved on 9/26/1995 per Act 345 1990

I, G.B. WARNKE, JR., in a field survey on 10/10/1995, 19     , do hereby certify that under requirements of P.A. 74, Michigan P.A. of 1970, the corner points mentioned in lines 1 and 2 above were in conformance with regulations and rules therefore as required in the current manual of survey instructions of the United States Department of the Interior, Bureau of Land Management or by a decree of a Court of Law and/or that the corner points mentioned in lines 3, 4 and 5 above were in conformance with the rules of the Michigan Board of Land Surveyors or by a Decree of a Court of Law; established, re-established, monumented, re-monumented, recovered, found as expressed below:

NOTE: Not more than 4 corners, all in the same town and range, may be recorded on this certificate.

A. Description of original monument and accessories and/or subsequent restoration:


1/4 Corner to Section 34 on Twp. Line (not common to adjoining Twp.) / by Day & Yensch Roads - 6 inch gravel surface. 1819, GLO Surveyor, J. Fletcher, set qr. Sec. post - witness: W. Oak 14 S74W 78. 1900's, old survey book, notes stone. A.J. Marino reference notes state F. Stone in 1939 being 66.25' W. to stone of NE1/4 Sec. 3 Raisinville Twp. 1973, M.R. Fleck survey, recorded in Liber 644, Page 965, ties to corner (material not noted). 1974, K.L. Suydam survey states found ref. rod. 1978, V.P. McMahon survey, recorded in Liber 778, Page 281, used corner (material not noted). 1991, Andrus recorded survey states found iron pin. 1994, J.C. Andrus recorded LCRC, Liber 3, Page 330, found pipe; dug without finding stone.

B. Description of corner evidence found and/or method applied in restoring or reestablishing corner:

8/95 - Found pipe / stone not found.  
10/10/95 - G.B. Warnke crew found 1/2" iron pipe 2" below surface, found 0.4' X 0.8" X 2.2" lime stone 18" deep, under top point of leaning iron, moved stone north & east to place 1" X 36" iron pipe with brass cap. Stone to large to move to look for post.

C. Description of monument for corner and accessories established to perpetuate locating the position of the corner:

Set 1" X 36" iron pipe with brass cap to replace found pipe and is accepted as the best available evidence of the position of the original corner and witnesses:  
West 67.41 feet to a found 1/2" iron pipe (H-1 6/7 Raisinville)  
West +/- 31 feet to the centerline of Yench Pavement  
North 30° East 56.30 feet to found PK in west face of 20" Walnut  
North 45° East 34.91 feet to found PK in west face of 24" Catalpa  
North 80° West 101.50 feet to top centerline of underground telephone box

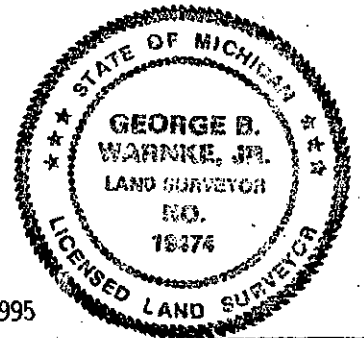

Signed by [Signature]  
Surveyor's Michigan License No. 19474

Date 10/10/1995

⑨ H-13, T5S, R7E, LONDON TWP. 4 66