

MAY 20 1997

LAND CORNER RECORDATION CERTIFICATE
Filing Requirement of Act 74, Mich. P.A. 1970

RECORDED
97 JUN 19 PM 2:07

For corners in
MONROE (58)

(County)

Located in:

Corner Code #

G.B. WARNKE - 1996 CORNER

1. Public Land Survey

T _____ R _____

T _____ R _____

LONDON TWP.

T 5S R 7E

K-6

T _____ R _____

2. Property Controlling
in Section

S _____ T _____ R _____

S _____ T _____ R _____

3. Miscellaneous
Property in Sec.

S _____ T _____ R _____

S _____ T _____ R _____

4. Lot No. _____, Recorded Plat _____

5. Private Claims _____

1/4 Corner to Sections 13 & 14

On Granlick Road (gravel) being 1/2 mile north of Allison Road

I, G.B. WARNKE, JR., in a field survey on 1996, 19 _____, do hereby certify that under requirements of P.A. 74, Michigan P.A. of 1970, the corner points mentioned in lines 1 and 2 above were in conformance with regulations and rules therefore as required in the current manual of survey instructions of the United States Department of the Interior, Bureau of Land Management or by a decree of a Court of Law and/or that the corner points mentioned in lines 3, 4 and 5 above were in conformance with the rules of the Michigan Board of Land Surveyors or by a Decree of a Court of Law; established, re-established, monumented, re-monumented, recovered, found as expressed below:

NOTE: Not more than 4 corners, all in the same town and range, may be recorded on this certificate.

A. Description of original monument and accessories and/or subsequent restoration:

1847, GLO Surveyor, Orange Risdon, set 1/4 Sec. post & witnesses:

B. Oak 12 S74°W 1.22 & B. Oak 12 S80°W 1.34;

1971, F.W. Liddle & Assoc. (Fred T. Ayers, Surveyor) survey (#11759) shows K-6, but does not state what is at corner;

1973, Case & Fleck recorded survey (L.650, Pg.484) notes I.P. (3 Wit.);

1979, F.T. Ayers & Assoc. recorded survey (L. 792, Pg. 982-984 & L. 796, Pg. 580-582) notes found I.P. (4 wit.)

B. Description of corner evidence found and/or method applied in restoring or reestablishing corner:

Oct. 1995, G.B. Warnke & Associates crew found a 3/4 inch (mangled on top) iron pipe and witnesses are similar to Ayer's recorded survey.

11/12/1996, corner was approved by Remonumentation Peer Group - reference corner dossier for further info.

12/17/1996, set 1" x 36" iron pipe with brass remonumentation cap to replace found 3/4" iron pipe and witnesses are shown below.

RATIFIED BY PEER GROUP
PA 345 OF 1990
MONROE COUNTY, MICHIGAN

date: 11/12/1996

County Rep.: [Signature]

C. Description of monument for corner and accessories established to perpetuate locating the position of the corner:

Set 1" x 36" iron pipe with brass remonumentation cap to replace found 3/4 inch (mangles on top) iron pipe and is accepted as the best available evidence of the position of the original corner and witnesses:

West 25.23 to set nail/shiner in east face of 36 inch Oak

South 45° West 40.25 feet to found PK nail in southeast face of 18 inch Oak

South 30° West 58.90 feet to found PK nail in southeast face 24 inch Oak

North 20° West 76.80 feet to set nail/shiner in east face 14 inch Oak


Signed by

[Signature]

Date

12/23/1996

Surveyor's Michigan License No.

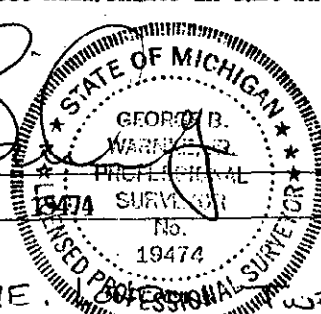

FORM APPROVED BY MICHIGAN STATE BOARD OF LAND SURVEYORS, JAN 23 1997, REVISED MAY 24 1997, REVISED JAN 23 1997

(11) K-6, T5S, R7E