

RATIFIED BY PEER GROUP  
PA 345 OF 1990  
MONROE COUNTY, MICHIGAN

date: 10/24/95  
County Rep.: [Signature]

LAND CORNER RECORDATION CERTIFICATE  
Filing Requirement of Act 74, Mich. P.A. 1970

For corners in  
Monroe (58)

Located In:

Corner Code #

- |                                       |   |     |    |
|---------------------------------------|---|-----|----|
| 1. Public Land Survey<br>Exeter Twp.  | T | R   |    |
|                                       | T | 5SR | 8E |
|                                       | T | R   |    |
|                                       | T | R   |    |
| 2. Property Controlling<br>in Section | S | T   | R  |
|                                       | S | T   | R  |
| 3. Miscellaneous<br>Property in Sec.  | S | T   | R  |
|                                       | S | T   | R  |

E-7  
SURVEY &  
REMONUMENTATION  
APR 04 1996

Register of Deeds Stamp & File Number


COMMISSION

4. Lot No. \_\_\_\_\_, Recorded Plat \_\_\_\_\_  
5. Private Claims \_\_\_\_\_

1995 REMONUMENTATION PROGRAM

I, G.B. WARNKE, JR., in a field survey on Sept. - Dec., 1995, 19\_\_\_\_, do hereby certify that under requirements of P.A. 74, Michigan P.A. of 1970, the corner points mentioned in lines 1 and 2 above were in conformance with regulations and rules therefore as required in the current manual of survey instructions of the United States Department of the Interior, Bureau of Land Management or by a decree of a Court of Law and/or that the corner points mentioned in lines 3, 4 and 5 above were in conformance with the rules of the Michigan Board of Land Surveyors or by a Decree of a Court of Law; established, re-established, monumented, re-monumented, recovered, found as expressed below.

NOTE: Not more than 4 corners, all in the same town and range, may be recorded on this certificate.

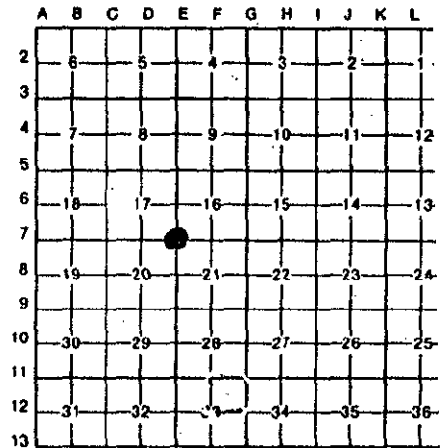

A. Description of original monument and accessories and/or subsequent restoration:

E-7, T5S, R8E, Section corner common to Sections 16, 17, 20 & 21 on Doty Road (gravel surface). 1847, GLO Surveyor, Orange Risdon, was going north between Sec. 20 & 21 & set post at Sec. 16, 17, 20 & 21, witnesses: Hickory 20" N87°E 10 links & Elm 9" N31°W 6 links. 1886, small, old book, (surveyor?), shows stone at NW corner of Sec. 21. Small, old book (date? & surveyor?) notes stone with witnesses and refers to B.2, Pg.84, J.W. White. 1904, County Surveyor #3, L.A. Howard, used stone. 1980, A.J. Marino found and used westerly 3/4" iron pipe. 6/1978, G.B. Warnke found R.R. spike and set iron pipe. 1980, G.B. Warnke used 1/2" iron pipe used 6/78 to restake school lot by L.A. Howard in 1904. 1986, Case & Fleck survey, recorded in Liber 977, Page 556, used easterly iron. 3/1987, G.B. Warnke recorded LCRC, Liber 3, Page 31, to 1/2" x 20" iron pipe & witnessed South 10° West 6.49 feet to 3/4" x 20" I. pipe. 5/1990, G.B. Warnke (continued in section B)

B. Description of corner evidence found and/or method applied in restoring or reestablishing corner:

( continued from section A )


recorded LCRC, Liber 3, Page 91, noting excavated area with backhoe & set 1/2" iron pipe inside 1" iron pipe in center of charred stake, which was under found stone that was moved 1.3 feet south to set irons, & witnessed SW 1.81 feet to old 3/4" iron pipe & East 4.95 feet to 1/2" iron pipe. 3/1993, J.C. Andrus recorded LCRC, Liber 3, Page 253, notes found I.P. from old Case & Fleck records (does not note other points).

( Section B info. )

9/1995 - found points per G.B. Warnke LCRC and checked witnesses. 10/24/95 - corner was Peer Group approved. 11/2/95 - set 1" x 36" iron pipe with brass remonumentation cap over existing capped iron pipe.

C. Description of monument for corner and accessories established to perpetuate locating the position of the corner:

Set 1 inch x 36 inch iron pipe with brass remonumentation cap to replace existing capped iron pipe and is accepted as the best available evidence of the position of the original corner and witnesses:  
Southwest 1.81' to found old 3/4" iron pipe  
East 4.95' to found 1/2" iron pipe  
West 27.8 feet to east face of broken fence post  
South 45° East 38.96 feet to nail & aluminum coin in north face of electric pole  
East 37.6 feet to west face of fence post  
South 107.0 feet to cross tile under Doty Road

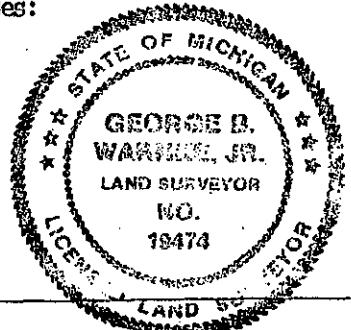

Signed by [Signature]  
Surveyor's Michigan License No. 19474

Date 11/02/1995