

RATIFIED BY PEER GROUP  
PA 345 OF 1980  
MONROE COUNTY, MICHIGAN

date: 9/26/1995

LAND CORNER RECORDATION CERTIFICATE  
Filing Requirement of Act 74, Mich. P.A. 1970

County Rep. [Signature]  
For corners in  
Monroe (58)

Located In: \_\_\_\_\_ Corner Code # \_\_\_\_\_

1. Public Land Survey Exeter Twp.	T _____ R _____ T <u>5S</u> R <u>8E</u> T _____ R _____ T _____ R _____	_____
2. Property Controlling in Section	S _____ T _____ R _____ S _____ T _____ R _____	_____
3. Miscellaneous Property in Sec.	S _____ T _____ R _____ S _____ T _____ R _____	_____

**SURVEY & REMONUMENTATION**  
Register of Deeds Stamp & File Number

RECEIVED FOR RECORD  
95 DEC 28 AM 9:02  
George B. Warnke  
REGISTER OF DEEDS  
MONROE COUNTY, MICH.

4. Lot No. \_\_\_\_\_, Recorded Plat APR 04 1996  
5. Private Claims \_\_\_\_\_

COMMISSION

	A	B	C	D	E	F	G	H	I	J	K	L	I
2	6	5	4	3	2	1							
3													
4	7	8	9	10	11	12							
5													
6	16	17	16	15	14	13							
7													
8	19	20	21	22	23	24							
9													
10	30	29	28	27	26	25							
11													
12	31	32	33	34	35	36							
13													

1995 REMONUMENTATION PROGRAM

I, G. B. WARNKE, JR., in a field survey on Sept. - Oct., 1995, 19\_\_\_\_, do hereby certify that under requirements of P.A. 74, Michigan P.A. of 1970, the corner points mentioned in lines 1 and 2 above were in conformance with regulations and rules therefore as required in the current manual of survey instructions of the United States Department of the Interior, Bureau of Land Management or by a decree of a Court of Law and/or that the corner points mentioned in lines 3, 4 and 5 above were in conformance with the rules of the Michigan Board of Land Surveyors or by a Decree of a Court of Law; established, re-established, monumented, re-monumented, recovered, found as expressed below:

**NOTE: Not more than 4 corners, all in the same town and range, may be recorded on this certificate.**

A. Description of original monument and accessories and/or subsequent restoration:

Section corner common to Sections 15, 16, 21 & 22 / not on road  
1847, GLO Surveyor, Orange Risdon, set post Cor. of Secs 15, 16, 21 & 22 - witnesses: W. Ash 10 S.65E. 6 lks. & Maple 5 N.45W. 40 lks. 1886 notes (surveyor?) states stake at northeast corner of Sec. 21. Old notes (date & surveyor?) state B2 - 85, N.E. Cor. Sec. 21, R.O. 10 N43E 4 & Maple 18 N42W 104. Old notes (date & surveyor?) state B.2 - P.70, stone at N.W. Cor., Elm 14" S79W 352 links. 1979, A.J. Marino notes state SW Cor. Sec. 15 - 36" dia. old tree @ intersection of NRS - E&W fences. 1990, G.B. Warnke LCRC, Liber 3, Page 102, set 1 1/2" x 36" post in base of old fence post.


B. Description of corner evidence found and/or method applied in restoring or reestablishing corner:

9/95, Found 1 1/2" x 36" stake in base of old fence post. 9/26/95, corner was Peer Group approved. 10/11/95, G.B. Warnke crew set 1" x 48" iron pipe with brass remonumentation cap to replace found 1 1/2 inch stake in base of old fence post.

C. Description of monument for corner and accessories established to perpetuate locating the position of the corner:

Set 1" x 48" iron pipe with brass remonumentation cap and is accepted as the best available evidence of the position of the original corner and witnesses:  
South 35° West 30.15 feet to nail in northwest face of 10" Elm tree  
North 45° East 51.6 feet to nail in south face of 12" Maple tree  
South 45° East 16.4 feet to nail in northeast face of 6" Elm tree  
North 15° West 13.9 feet to nail in east face of 8" Elm tree  
South 45° East 29.6 feet to nail in northeast face of 12" Maple tree

Signed by [Signature] Date 12/19/1995  
Surveyor's Michigan License No. 19474

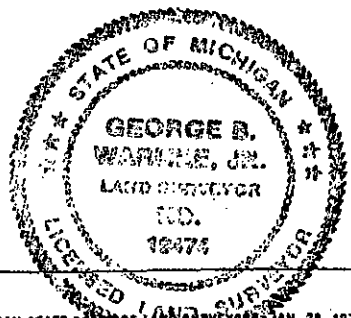

FORM APPROVED BY MICHIGAN STATE BOARD OF LAND SURVEYORS: JAN. 28, 1971  
REVISED MAY 14, 1975  
REVISED JAN., 1983