

RATIFIED BY PEER GROUP
PA 345 OF 1990
MONROE COUNTY, MICHIGAN

date: 10/24/95
County Rep.: [Signature]
For corners in

LAND CORNER RECORDATION CERTIFICATE
Filing Requirement of Act 74, Mich. P.A. 1970

RECEIVED FOR RECORD
95 DEC 29 AM 9:03
REGISTERED DEEDS
REGISTERED PLATS
REGISTERED INSTRUMENTS
Register of Deeds Stamp & File Number

Monroe (58) Located In: Corner Code #

1. Public Land Survey Exeter Typ: T 5S R 8E I-2

2. Property Controlling in Section S T R

3. Miscellaneous Property in Sec. S T R

SURVEY & REMONUMENTATION

APR 04 1996

4. Lot No. , Recorded Plat
5. Private Claims

COMMISSION

A	B	C	D	E	F	G	H	I	J	K	L	A
2	6	5	4	3	2	1						
3												
4	7	8	9	10	11	12						
5												
6	16	17	16	15	14	13						
7												
8	19	20	21	22	23	24						
9												
10	30	29	28	27	26	25						
11												
12	31	32	33	34	35	36						
13												

1995 REMONUMENTATION PROGRAM

I, G.B. WARNKE, JR. in a field survey on Oct-Nov, 1995, 19 , do hereby certify that under requirements of P.A. 74, Michigan P.A. of 1970, the corner points mentioned in lines 1 and 2 above were in conformance with regulations and rules therefore as required in the current manual of survey instructions of the United States Department of the Interior, Bureau of Land Management or by a decree of a Court of Law and/or that the corner points mentioned in lines 3, 4 and 5 above were in conformance with the rules of the Michigan Board of Land Surveyors or by a Decree of a Court of Law; established, re-established, monumented, re-monumented, recovered, found as expressed below:

NOTE: Not more than 4 corners, all in the same town and range, may be recorded on this certificate.

A. Description of original monument and accessories and/or subsequent restoration:


1/4 Corner common to Sections 2 & 3 / On Martinsville & Newburg Roads (gravel surface). 1819, GLO Surveyor, J. Fletcher, set qr. Sec. post - witnesses: Hickory 10 S.22W. 15 lks & Hickory 12 S.30E. 10lks. 1846-7, GLO Surveyor, Risdon, for remeasurement. 1877 & 1886, Monroe Co. Surveyor records note stone. 8/44, A.J. Marino survey notes STONE. 2/74, M.R. Fleck, File #18458, recorded in L664, Pg402, notes F. STONE. 4/77, I.J. Jekabson, Job #77-1-86, notes IRON PIPE. 12/77, G.B. Warnke LCRC, recorded in L2, Pg261, notes PINCHED IRON PIPE. 10/78, J. Fish LCRC, recorded in L2, Pg287, to FOUND PINCHED IRON. 10/78, Case & Fleck field notes show FD.I.P. 2/1979, G.B. Warnke, Job #79-24, recorded in L788, Pg572, & L789, Pg 384, notes FOUND PINCHED IRON PIPE. 7/1979, Robert Roskelly, Job #77-1-86, notes IRON PIPE. July 1993, G.B. Warnke recorded LCRC, L3, Pg306, to set 1/2" x 12" capped iron pipe over stone, which was found using Case & Fleck information. 10/1993, J.C. Andrus, Job #93S-6998, notes FD IRON PIPE. 1994, J. Straub, Job #93-1867, notes FND IRON.

B. Description of corner evidence found and/or method applied in restoring or reestablishing corner:

10/19/95, found point per LCRC, Liber 3, Page 306, and re-checked witnesses. 10/24/95, corner was Peer Group approved. 11/1/95, G.B. Warnke crew set 1" x 36" iron pipe with brass remonumentation cap to replace iron pipe.

C. Description of monument for corner and accessories established to perpetuate locating the position of the corner:

Set 1" x 36" iron pipe with brass remonumentation cap and is accepted as the best available evidence of the position of the original corer and witnesses:
North 2.32 feet to found 1/2" x 42" thin wall iron pipe
North 45° East 34.78 feet to found PK nail in SE face of telephone pole
North 45° West 42.80 feet to found PK nail in south face of guy pole
South 60° West 52.81 feet to found PK nail in NW face of electric pole
South 30° East 63.87 feet to set nail/shiner in west face of 15" Elm tree

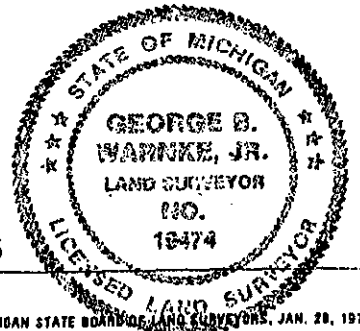

Signed by [Signature] Date 12/19/1995
Surveyor's Michigan License No. 19474

FORM APPROVED BY MICHIGAN STATE BOARD OF LAND SURVEYORS, JAN. 20, 1971
REVISED MAY 14, 1975
REVISED JAN., 1983

① I-2 T5S, R8E