

RATIFIED BY PEER GROUP
PA 345 OF 1990
MONROE COUNTY, MICHIGAN

date: Nov. 8, 1994

LAND CORNER RECORDATION CERTIFICATE
Filing Requirement of Act 74, Mich. P.A. 1970

County Rep.: [Signature]
For corners in
Monroe (58)
(County)

Located In: _____
Corner Code # _____

1. Public Land Survey Exeter Twp.	T _____ T <u>5S</u> R <u>R8E</u> T _____ T _____	_____	_____
2. Property Controlling in Section	S _____ S _____	T _____ T _____	R _____ R _____
3. Miscellaneous Property in Sec.	S _____ S _____	T _____ T _____	R _____ R _____

SURVEY &
REMONUMENTATION

Register of Deeds Stamp & File Number

APR 04 1996

4. Lot No. _____, Recorded Plat _____
5. Private Claims _____

COMMISSION

A	B	C	D	E	F	G	H	I	J	K	L	M
2	6	5	4	3	2	1						
3												
4	7	8	9	10	11	12						
5												
6	18	17	16	15	14	13						
7												
8	19	20	21	22	23	24						
9												
10	30	29	28	27	26	25						
11												
12	31	32	33	34	35	36						
13												

GEORGE B. WARNKE, JR. CORNER

I, G.B. WARNKE, JR., in a field survey on 1994 & 1995, 19____, do hereby certify that under requirements of P.A. 74, Michigan P.A. of 1970, the corner points mentioned in lines 1 and 2 above were in conformance with regulations and rules therefore as required in the current manual of survey instructions of the United States Department of the Interior, Bureau of Land Management or by a decree of a Court of Law and/or that the corner points mentioned in lines 3, 4 and 5 above were in conformance with the rules of the Michigan Board of Land Surveyors or by a Decree of a Court of Law, established, re-established, monumented, re-monumented, recovered, found as expressed below:

NOTE: Not more than 4 corners, all in the same town and range, may be recorded on this certificate.

A. Description of original monument and accessories and/or subsequent restoration:

Section corner common to Section 26, 27, 34 & 35, being on Zink Road which is a gravel surface. 1846, G.L.O. Surveyor Orange Risdon set post at corner of Sections 26, 27, 34 and 35. Witnesses: Elm 12 inch N. 81 W., 10 links, Elm 20 inch N. 16 E., 15 links. 1877, W.D. Chapman survey note-stone at all corners of Section. 1955, A.J. Marino field notes found stone. 1969, A.J. Marino field notes found stone. 1972, Case & Fleck field notes found spike, found stone, set steel rod. 1977, A.J. Marino field notes found stone.

B. Description of corner evidence found and/or method applied in restoring or reestablishing corner:


3/2/1994, found stone (4" deep), (3/4" iron pipe was 0.37 feet North and 0.20 feet West of high point of stone) and witnessed to stone as shown below. Recorded Case & Fleck surveys, Liber 627, Pages 642 to 648, calls for a found railroad spike or corner not stated. Witness per recorded surveys S. 35 W. = 128.75 to NE corner of barn S. 75 W. = 74.80 to nail in tree N. 10 W. = 26.20 to 12" pin oak. 11/8/1994 - corner was Peer Group approved. 10/19/95 - set 1" x 36" iron pipe with brass remonumentation replacing found stone. Placed pieces of the stone and pieces of metal in hole around iron pipe.

C. Description of monument for corner and accessories established to perpetuate locating the position of the corner:

Set 1" x 36" iron pipe with brass remonumentation cap and is accepted as the best available evidence to the position of the original corner and witnesses:
North 15° West - 25.70 feet to found nail/shiner in southeast face 12 inch tree
North 70° East - 100.80 feet to found PK nail in south face of 18 inch tree
North 65° West - 92.33 feet to found PK nail in south face of 18 inch tree
South 35° West - 128.82 feet to northeast corner of barn

Signed by [Signature]
Surveyor's Michigan License No 19474

Date 12/4/1995

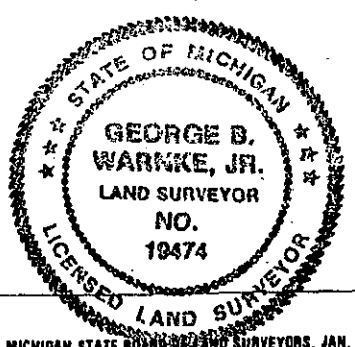

FORM APPROVED BY MICHIGAN STATE BOARD OF LAND SURVEYORS, JAN. 28, 1971
REVISED MAY 14, 1975
REVISED JAN., 1983

G.B. Warnke, Jr., Corner 1994 - Approved & 1995 - Monumented

(12) I-11, T5S, R8E, EXETER TWP.