

RECEIVED FOR RECORD
 95 NOV 12 AM 8:31

LAND CORNER RECORDATION CERTIFICATE
 Filing Requirement of Act 74, Mich. P.A. 1970

For corners in
MONROE (58)
 (County)

Located In:

Corner Code #

- 1. Public Land Survey T _____ R _____
 T _____ R _____
 EXETER T 5S R 8E M-13
 T _____ R _____
- 2. Property Controlling S _____ T _____ R _____
 in Section S _____ T _____ R _____
- 3. Miscellaneous S _____ T _____ R _____
 Property in Sec. S _____ T _____ R _____

Eric Allen
 REGISTER OF DEEDS
 MONROE COUNTY, MICH

Register of Deeds Stamp & File Number

- 4. Lot No. _____, Recorded Plat _____
- 5. Private Claims _____

1996 REMONUMENTATION PROGRAM CORNER

I, G.B. WARNKE, JR., in a field survey on 1996, 19____, do hereby certify that under requirements of P.A. 74, Michigan P.A. of 1970, the corner points mentioned in lines 1 and 2 above were in conformance with regulations and rules therefore as required in the current manual of survey instructions of the United States Department of the Interior, Bureau of Land Management or by a decree of a Court of Law and/or that the corner points mentioned in lines 3, 4 and 5 above were in conformance with the rules of the Michigan Board of Land Surveyors or by a Decree of a Court of Law; established, re-established, monumented, re-monumented, recovered, found as expressed below:

	A	B	C	D	E	F	G	H	I	J	K	L
2	6	5	4	3	2	1						
3												
4	7	8	9	10	11	12						
5												
6	18	17	16	15	14	13						
7												
8	19	20	21	22	23	24						
9												
10	30	29	28	27	26	25						
11												
12	31	32	33	34	35	36						
13												

NOTE: Not more than 4 corners, all in the same town and range, may be recorded on this certificate.

A. Description of original monument and accessories and/or subsequent restoration:

Section corner common to Section 36 at corner of Township / Common to M-1, T6S, R8E, Raisinville Twp. On Exeter Road being north of Toben Road (3" tan chip surface over 3" yellow sand over topsoil) 1817, GLO Surveyor, J. Fletcher, East Boundary, South on the E. Boundary of Sec. 1 From Holmes' corner of Ts.5 & 6S., Rs.8 & 9E. - witnesses: W. Oak 18 N.76W. 87 lks & W. Oak 12 S.61E. 19 lks 1817, GLO Surveyor, J. Fletcher, T6S, R9E, Intersect W. Boundary 32.88 chs. N. of post cor. of Ts.5 & 6S., R.8E. - Set post intersections cor. of Ts.5 & 6S., R.9E. - witnesses: W. Oak 16 S5W 180 & W. Oak 6 S27E 169. This corner stands in the edge of a swale.
 Section A continued on reverse side

B. Description of corner evidence found and/or method applied in restoring or reestablishing corner:

1995, G.B. Warnke (performing survey using M-1, T6S, R8E) found railroad spike at surface (concrete nail & washer unknown location) & found 1/2" x 12" iron rod being 0.60 feet north of railroad spike on same centerline. Dug 20" x 24" hole and probed in all directions; no further evidence found. Replaced railroad spike with 1" x 36" iron pipe and monument box and witnessed as shown below.
 8/27/96 - corner approved at Peer Group Remonumentation Meeting.
 9/10/96 - set brass remonumentation cap on previously set pipe in box.

SURVEY &
 REMONUMENTATION
 DEC 16 1996
 COMMISSION

C. Description of monument for corner and accessories established to perpetuate locating the position of the corner:


Set 1" x 36" iron pipe in monument box with brass remonumentation cap to replace found railroad spike and is accepted as the best available evidence of the position of the original corner and witnesses:
 West 33.10 feet to found 1/2" pinched pipe
 North 40° West 47.44 feet to found nail/shiner in east face of 8" Pine tree
 South 25° West 84.87 feet to found PK nail/shiner in west root of 32" Oak tree
 South 30° West 59.86 feet to found nail/shiner in east face of 30" Oak tree
 South 35° East 41.90 feet to top of south end of 12" C.M.P.

RATIFIED BY PEER GROUP
 PA 345 OF 1990
 MONROE COUNTY, MICHIGAN
 date: 8/27/1996
 County No. 58

Signed by _____

Date 10/16/1996

Surveyor's Michigan License No. _____

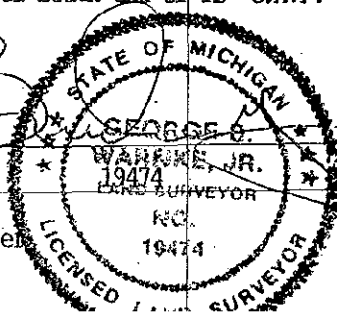

1996 Remonumentation Program Corner

Section A continued

1887, W. Baldwin (drawing) notes witnesses (material not noted):

Burr Oak 15 S64E 44 1/? & Burr Oak 12 N86 1/2W 9

June 1953, A.J. Marino (field notes) shows "P. cap. checks on line between irons & centerline blacktop"

10/26/53, Case & Fleck (drawing) notes "SE corner Sec. 36" (no material noted).

6/8/54, Case & Fleck (drawing copied 2/22/64 by A.J. Marino) notes "SE cor. Sec. 36" (no material noted).

Feb. 21, 1956, A.J. Marino (field notes) notes "nail with washer".

March 1964 thru August 1973, A.J. Marino shows using corner 6 times without noting material.

5/2/72, A.J. Marino (field notes) show "R.R. spike" & witnesses:

NW'ly 41.72' P. pole & SW'ly 60.10' 22" Maple

S'ly along centerline of Exeter Road 409.13' to Toben Road to F.I.

April 8, 1976, Case & Fleck (survey #19282) notes "Fd. P.K. Nail" - witnesses:

West 42.70' nail P. Pole & S30°W 60.65' nail 24" tree & S70°W 118.92' NE cor. 1 sty. fm.

12/31/80, A.J. Marino notes "Fd. R.R. Spike".

4/26/89, G.B. Warnke (field notes for M.L.) note "Fd. R.R. Spike"

SURVEY &
REMONUMENTATION

DEC 16 1996

COMMISSION