

# SURVEY & REMONUMENTATION

FEB 13 1998

## SECTION

### LAND CORNER RECORDATION CERTIFICATE Filing Requirement of Act 74, Mich. P.A., 1970

For corners in

<u>Monroe</u> <small>(County)</small>	Located In:	Corner Code #
	<u>Ash Twp.</u>	
1. Public Land Survey	T <u>5S</u> R <u>9E</u>	<u>F-5</u>
	T _____ R _____	_____
	T _____ R _____	_____
	T _____ R _____	_____
2. Property Controlling in Section	S _____ T _____ R _____	_____
	S _____ T _____ R _____	_____
3. Miscellaneous Property in Sec.	S _____ T _____ R _____	_____
	S _____ T _____ R _____	_____
4. Lot No. _____, Recorded Plat _____		
5. Private Claims _____		

RECEIVED FOR RECORD  
 97 DEC 30 PM 3:41  
 REGISTER OF DEEDS  
 MONROE COUNTY, MICH.  
*Handwritten Signature*


Register of Deeds Stamp & File Number

I, George B. Warnke, Jr., in a field survey on October - December, 1997 do hereby state that under requirements of P.A. 74, Michigan P.A. of 1970, the corner points mentioned in lines 1 and 2 above were in conformance with regulations and rules therefore as required in the current manual of survey instructions of the United States Department of the Interior, Bureau of Land Management or by decree of a Court of Law and / or that the corner points mentioned in lines 3, 4 and 5 above were in conformance with the rules of the Michigan Board of Land Surveyors or by a Decree of a Court of Law; established, re-established, monumented, recovered, found as expressed below:

**NOTE: Not more than 2 corners, all in the same town and range, may be recorded on this certificate.**

**1997 REMONUMENTATION PROGRAM CORNER**

- A. Description of original monument and accessories and/or subsequent restoration:
- 1817, GLO Surveyor, Joseph Fletcher set the 1/4 section post at average distance from which a W. Ash 10 in. dia bears S 65 E 38 lks, and a W Oak 12 in. dia bears S 5 W 33 lks
  - 1878, Fred Buckley shows found stone - no witnesses
  - 1947, AJ Marino notes show I.P. - no witnesses
  - 1948, AJ Marino surveys and notes show "cut cross"
  - 1956, AJ Marino survey and notes shows cross
  - 1957, AJ Marino surveys and notes do not show what was found
  - 1960, AJ Marino notes show P. cap
  - 1972, AJ Marino notes show F. PK - witnesses: NE 37.00' tel. pole / SE 39.78' tel. pole / NW 25.20' nail in stump  
AJ Marino notes show F. PK - witnesses: N 34 E 37.15' tel. pole / S 65 E 84.81' top nut hydrant / S 50 E 40.35' P pole / S 60 W 33.63' NE cor conc hd. wall / N 38 W 24.70' nail in stump
  - 1973, Community Consultants Inc. survey (Liber 652, Page 320) shows corner but does not show what was found
  - 1976, Ervin P Miller (Michigan Dept. of State Highways and Transportation) survey (Liber 725, Page 112) and LCRC (Liber 2, Page 153) note found RR spike replaced with mushroom head iron in monument box - witnesses: N 45° E 37.35' tele pole / S 35° E 40.70' power pole / S 55° W 34.31' drill hole in east end of headwall / N 50° W 33.74' drill hole in east end of headwall
  - 1977, Arthur Crossman survey (#5134, Liber 738, Page 930) and Kenneth Wilkerson LCRC (Liber 2, Page 205) show 1" iron in monument box - witnesses: Nail SE side pole N 40° E 37.33' / PK nail SW side DE pole S 45° E 41.50' / PK nail in 16" stump N 50° E 26.90'
  - 1979, AJ Marino survey shows corner but does not show what was found
  - 1982, Kenneth Wilkerson LCRC (Liber 2, Page 401) shows found 1" iron rod in monument box - same witnesses as 1977 LCRC
  - 1985, G.B. Warnke survey (#85-346) shows 1" iron in mon. box - same witnesses as 1977 LCRC

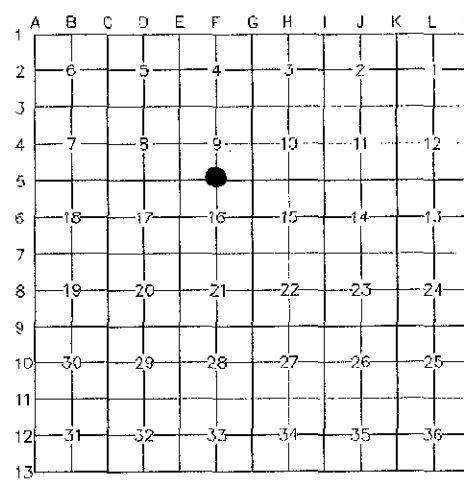

- B. Description of corner evidence found and/or method applied in restoring or re-establishing corner:  
 10/7/1997, G.B. Warnke crew found 1" iron in existing monument box in asphalt & concrete pavement for Carleton Rockwood & Fessne Roads & checked with previous witnesses.


**RATIFIED BY PEER GROUP, PA 345 OF 1990, MONROE COUNTY, MICHIGAN, DATE 10/14/1997, COUNTY REP.** *[Signature]*

12/15/1997, G.B. Warnke crew wired on yellow plastic remonumentation cap to found 1" iron rod in existing monument box

- C. Description of monument for corner and accessories established to perpetuate locating the position of the corner:  
 Wired on yellow plastic remonumentation cap to found 1" iron rod in existing monument box and is accepted as the best available evidence of the position of the original corner. Witnesses:  
 North 40° East 37.33 feet to nail in southeast face of pole  
 South 45° East 41.07 feet to PK nail in southwest face of electric pole  
 South 65° East 84.48 feet to top nut of hydrant  
 South 55° West 46.50 feet to top centerline of water manhole

Signed by *[Signature]*  
 Surveyor's Michigan License No. 19474

Date December 16, 1997

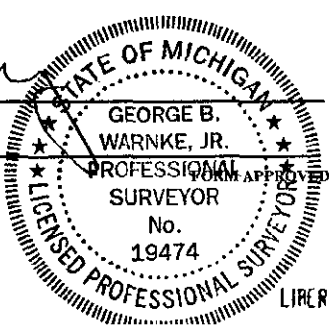

FORM APPROVED BY MICHIGAN STATE BOARD OF LAND SURVEYORS, JAN. 28, REVISED MAY 14, REVISED JAN., REVISED OCT.,