

SURVEY & REMONUMENTATION

FEB 13 1998

RECEIVED FOR RECORD

97 NOV 12 PM 1:47

SECTION

LAND CORNER RECORDATION CERTIFICATE
Filing Requirement of Act 74, Mich. P.A. 1970

Mari Allen
REGISTER OF DEEDS
MONROE COUNTY, MICH

For corners in

MONROE (58)

(County)

Located In:

Corner Code #

1. Public Land Survey

T ___ R ___

T ___ R ___

ASH TWP.

T 5S R 9E K-10

T ___ R ___

2. Property Controlling in Section

S ___ T ___ R ___

S ___ T ___ R ___

3. Miscellaneous Property in Sec.

S ___ T ___ R ___

S ___ T ___ R ___

Register of Deeds Stamp & File Number

4. Lot No. _____, Recorded Plat _____

5. Private Claims _____

I, G.B. WARNKE, JR., in a field survey on 1997, 19 ___ do hereby state that under requirements of P.A. 74, Michigan P.A. of 1970, the corner points mentioned in lines 1 and 2 above were in conformance with regulations and rules therefore as required in the current manual of survey instructions of the United States Department of the Interior, Bureau of Land Management or by a decree of a Court of Law and /or that the corner points mentioned in lines 3, 4 and 5 above were in conformance with the rules of the Michigan Board of Land Surveyors or by a Decree of a Court of Law; established, re-established, monumented, recovered, found as expressed below:

NOTE: Not more than 2 corners, all in the same town and range, may be recorded on this certificate.

1997 G.B. WARNKE CORNER
1/4 Corner to Sections 25 & 26
Not in road

- A. Description of original monument and accessories and/or subsequent restoration:
- 1817 GLO Surveyor, J. Fletcher, set post - witnesses: Sugar 12 in N68E 15 lks & Sugar 9 in S14W 25 lks
 - 1968 F.W. Liddle & Assoc. survey indicates setting iron stake
 - 1975 Vincent P. McMahon survey shows corner but does not state what is at point
 - 1975 Roskelly, Jekabson & Assoc. survey shows corner but does not state what is at point
 - 1976 Roskelly, Jekabson & Assoc. survey shows corner but does not state what is at point
 - 1979 Case & Fleck survey found 2 1/2" pipe
 - 1990 J.C. Andrus survey found existing iron pipe
 - 1991 G.B. Warnke LCRC, Liber 3, Page 192, notes 3/8 inch rod set over 1/2 inch pipe 15 inches deep
 - G.B. Warnke & Assoc. survey notes found 3/8 inch rod over 1/2 inch pipe

B. Description of corner evidence found and/or method applied in restoring or reestablishing corner:


1996, G.B. Warnke & Assoc. survey found 3/8 inch pipe per LCRC, Liber 3, Page 192, and witnesses as shown below.

8/12/1997, Ratified by Peer Group, PA 345 of 1990, Monroe County, Michigan, County Rep. *[Signature]*
8/20/97, set 1" x 36" iron pipe with brass remonumentation cap over found 3/8" rod in 1/2" pipe. No other evidence found.

C. Description of monument for corner and accessories established to perpetuate locating the position of the corner:

Set 1" x 36" iron pipe with brass remonumentation cap over found 3/8" rod in 1/2" pipe is accepted as the best available evidence of the position of the original corner. Witnesses:
West 0.4 feet to found 2 inch (dia) by 3 feet tall steel post
North 10° West 5.70 feet to found nail and washer in south face 12 inch Elm
South 05° West 4.42 feet to found nail and washer in northwest face 10 inch Elm
South 30° West 11.35 feet to found nail and washer in north face 12 inch Elm
North 2582.33 feet to K-9, T5S, R9E, (also approved 8/12/97)
North 1252.97 feet to iron on Swan Creek Road

Signed by *[Signature]*
Surveyor's Michigan License No. 19474

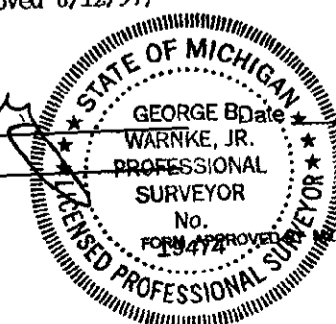

10/6/1997

LIRER

4 Feb 298

	A	B	C	D	E	F	G	H	I	J	K	L
1												
2	6			5			4			3		2
3												
4	7						9			10		11
5												
6	18						16			15		14
7												
8	19						21			22		23
9												
10	30						29			28		27
11												
12	31						32			33		34
13												