

SURVEY & REMONUMENTATION

APR 28 1995

COMMISSION

RECEIVED FOR RECORD

94 DEC -9 PM 12:44

RATIFIED BY PEER GROUP
PA 345 OF 1990
MONROE COUNTY, MICHIGAN

date: 10-25-94
County Rep.: [Signature]

LAND CORNER RECORDATION CERTIFICATE
Filing Requirement of Act 74, Mich. P.A. 1970

For corners in

MONROE
(County)

Located In: ASH TWP. Corner Code ##

- | | | | | | |
|---------------------------------------|---------|--------------|--------------|-------|-------|
| 1. Public Land Survey | | T <u>5</u> S | R <u>9</u> E | | M-5 |
| | | T _____ | R _____ | _____ | _____ |
| | | T _____ | R _____ | _____ | _____ |
| | | T _____ | R _____ | _____ | _____ |
| 2. Property Controlling
in Section | S _____ | T _____ | R _____ | _____ | _____ |
| | S _____ | T _____ | R _____ | _____ | _____ |
| 3. Miscellaneous
Property in Sec. | S _____ | T _____ | R _____ | _____ | _____ |
| | S _____ | T _____ | R _____ | _____ | _____ |

Mari Allen
REGISTER OF DEEDS
MONROE COUNTY, MICH

Register of Deeds Stamp & File Number

4. Lot No. _____, Recorded Plat _____
5. Private Claims _____

1994 MONROE COUNTY REMONUMENTATION PROGRAM

Peer Group approved corner on 10/25/1994 per Act. 345 of 1990.

I, G.B. WARNKE, JR., in a field survey on 11/15/1994, 19_____, do hereby certify that under requirements of P.A. 74, Michigan P.A. of 1970, the corner points mentioned in lines 1 and 2 above were in conformance with regulations and rules therefore as required in the current manual of survey instructions of the United States Department of the Interior, Bureau of Land Management or by a decree of a Court of Law and/or that the corner points mentioned in lines 3, 4 and 5 above were in conformance with the rules of the Michigan Board of Land Surveyors or by a Decree of a Court of Law; established, re-established, monumented, re-monumented, recovered, found as expressed below:

NOTE: Not more than 4 corners, all in the same town and range, may be recorded on this certificate.

	A	B	C	D	E	F	G	H	I	J	K	L	M
2	6	5	4	3	2	1							
3													
4	7	8	9	10	11	12							
5													
6	13	17	16	15	14	13							
7													
8	19	20	21	22	23	24							
9													
10	30	29	28	27	26	25							
11													
12	31	32	33	34	35	36							
13													

A. Description of original monument and accessories and/or subsequent restoration:

M-5, T5S, R9E, Ash Township, Monroe County - ID No. 58 (not common to A-5, T5S, R10E)
Section Corner Common to Sections 12 and 13 on Township Line (Berlin Road - gravel surface)
1817, Joseph Fletcher, D.S., set post cor. of Sect. 12 and 13: Sugar 10 (inch) S.61°W. 10 (links) & Elm 10 (inch) N35°W. 12 (links). 1903, L.A. Howard notes found stone misplaced and set stake at proper point. 1928, J.W. White notes set pipe. 1951 to 1967, A.J. Marino notes found iron pipe. 1967 field notes show found iron pipe. 1987 and 1989, J.C. Andrus survey, recorded in Liber 1002, Page 0807, notes found iron pipe and survey No. 89S-5527.

B. Description of corner evidence found and/or method applied in restoring or reestablishing corner:


M-5 - 7/28/1994, excavated to 1 foot found 1 inch I.D. iron pipe (1-1/2 inch OD) 0.4 feet deep, 2 to 3 feet west of centerline of gravel Road and witnessed as shown below. 11/15/94, set 1 inch x 36 inch iron pipe with brass remonumentation cap to replace found iron pipe.

C. Description of monument for corner and accessories established to perpetuate locating the position of the corner:

M-5 - Set 1 inch x 36 inch iron pipe with brass remonumentation cap to replace found iron pipe and is accepted as the best available evidence of the position of the original corner and Witnesses:
South 40° East 25.86 feet to P.K. nail north face of electric pole
South 45° East 68.65 feet to northwest corner of concrete floor slab of garage
North 40° West 76.38 feet to southeast corner building foundation No. 3994, Carleton-Rockwood Road
North 70° West 99.19 feet to southeast corner of concrete block garage
West 33.00 feet to capped iron JCA No. 16031
North 15° East 73.53 feet to P.K. nail in easterly face of electric pole
North 158 feet to centerline of pavement Carleton-Rockwood Road
North 159.80 feet to P.K. nail at A-5 T5S, R10E

Signed by [Signature]
Surveyor's Michigan License No. 19474

Date 11/15/1994

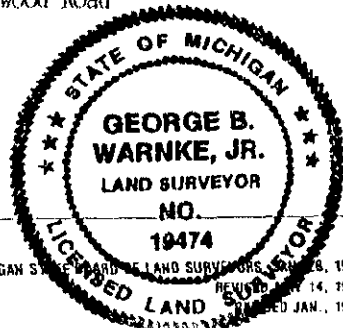

344 405